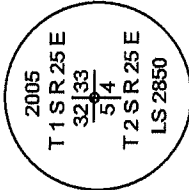
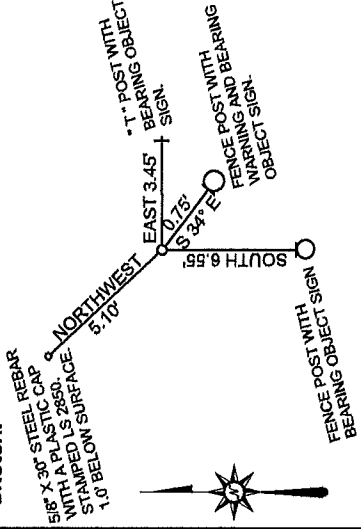
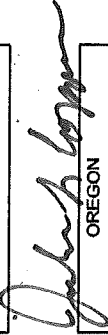


OREGON PUBLIC LAND CORNER REPORT / RESTORATION REPORT

MORROW COUNTY SURVEYOR'S OFFICE

SECTION	32 33 5 4	TOWNSHIP	T 1 S T 2 S	RANGE	R 25 E
MORROW COUNTY, OREGON		DATE: 3 MAY 2006			
CORNER DESIGNATION:					
SECTION CORNER COMMON TO SECTIONS 32, 33, T 1 S R 25 E AND SECTIONS 5, 4, T 2 S, R 25 E., WILLAMETTE MERIDIAN, MORROW COUNTY, OREGON.					
Previous Renewals / Surveys, etc. GLO CONTRACT 119, 15 FEB. 1867 BY THOMPSON AND PENGRA SET POST AND CHARRED STAKE					
Monument(s) & Accessories Found: (Condition & Source) FENCE CORNER ONLY. ACCEPTED AS BEST EVIDENCE OF ORIGINAL CORNER REMAINING.					
Monument Detail:			Sketch:		
					
2 3/8" BRASS CAP STAMPED AS SHOWN ON A 2" ID X 30" FLAIRED STEEL PIPE.					
Monument Set (Procedures and Description): 2 3/8" BRASS CAP STAMPED AS SHOWN ON A 2" ID X 30" FLAIRED STEEL PIPE.					
New Accessories: SET A 5/8" X 30" STEEL REBAR 1 FOOT BELOW SURFACE NORTHWEST 5.10'. SET A " T " POST WITH BEARING OBJECT SIGN EAST 3.45' PLACED A WARNING SIGN AND A BEARING OBJECT SIGN ON EXISTING WOOD FENCE POST S 34° E 0.75'. PLACED A BEARING OBJECT SIGN ON AN EXISTING FENCE POST SOUTH 6.55'.					
Location & Comments:			Compass Declination:		
AT A FENCE CORNER, THE EASTERLY RUN BEING REMOVED AND ABOUT 150' SOUTHEAST OF A COUNTY ROAD.			NOT DETERMINED		
Firm / Agency		SURVEYOR'S SEAL			
COPPOCK SURVEYING PO Box 495 HEPPNER, OR 97836		REGISTERED PROFESSIONAL LAND SURVEYOR  OREGON JANUARY 20 1998 JUDSON L. COPPOCK 2850			
Party Chief					
JUDSON L. COPPOCK LS 2850					
Notes		RENEWAL DATE: DEC. 31, 2007			
Witness		SHANNON BENEFIT			