

CERTIFIED RECORD OF LAND CORNER MONUMENTATION

Corner Code No. R-23
Note: Monument marked as shown below


T 15, R 26E., W.M.

History of original corner establishment:

This corner was originally established by Thompson & Penner, U.S. Deputy Surveyors, under Joint Contract No. 119, dated February 15, 1867.

The original notes state:

Set stone 14 X 10 X 8 ins. as 1/4 Section Corner.

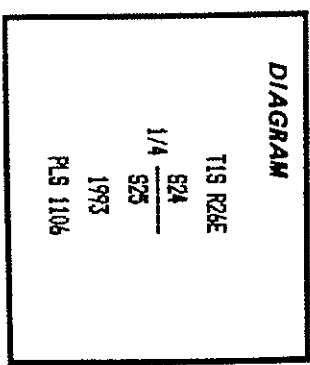

Corner No.
Compass Declination: 18.0°

Description of corner evidence found:

Ancient fence jack and 4 foot diameter stone mound. Old fences go South and West of the fence jack. Several stones of record size exist, but no chiseled stone markings were found.

This position was confirmed by survey and aerial photograph measurements to nearby fence and field lines.

Description of monument and accessories | established to perpetuate the original location of this corner:

At the North end of the ancient fence jack, at the intersection of old fences going South and West, set a 2 1/2" brass cap on 1 1/4" by 30" galvanized iron pipe, 24" in the ground and surrounded with a mound of earth and stone.

No trees or natural bearing objects are available, and fields North and East of the corner are farmed.

Referenced the corner as follows:

- A 5/8" by 30" iron pin with 1 1/2" yellow plastic cap bears S 0 1/2° W 37.45'
- A 5/8" by 30" iron pin with 1 1/2" yellow plastic cap bears S 31° W 26.9'
- A 5/8" by 30" iron pin with 1 1/2" yellow plastic cap bears S 39° W 44.7'
- A 5/8" by 30" iron pin with 1 1/2" yellow plastic cap bears S 88° W 37.25'.

The yellow plastic caps are marked "W.R. Wells, PLS 1106". Wired a bearing object sign to each of the iron pin reference monuments.

Set steel fence post 2.8' Southwest of corner monument and attached witness corner sign.

REGISTERED PROFESSIONAL LAND SURVEYOR

William R. Wells

OREGON JULY 22, 1977 WILLIAM R. WELLS 1106

Expires 12-31-94

 by
 (COUNTY OFFICIAL) (DEPUTY)