


CORNER RESTORATION

CORNER: Corner common to Sections 13 & 24, T2N, R22E, and Sections 18 & 19, T2N, R23E, W.M.

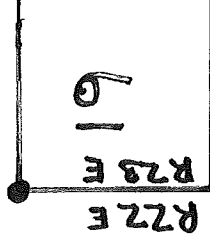

ORIGINAL SURVEY BY: David P. Thompson


CONTRACT NUMBER: 119

CONTRACT DATE: February 15, 1867

ORIGINAL DESCRIPTION: Set post in mound of earth with charred stake pits. No bearing objects.

RESTORATION BY, STAMP, AND DATE:

Benjamin B. Beseda, PLS 50800
 Field Work completed July 19, 2011
 Field Crew Bradley R. Huffmon, PLS 2786
 And Kelly McCargar, PLS 60179

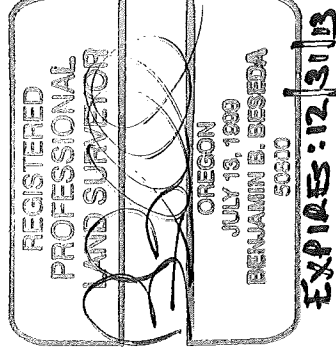

EVIDENCE FOUND:

Corner position not reestablished subsequent to GLO Survey. ALTA/ACSM Survey for Willow Creek Wind Farm calculated corner position at fence corner remnants. Field survey verified and accepted this location. No evidence of the original corner was found.

DESCRIPTION OF MONUMENTS AND ACCESSORIES SET AND METHODS USED:

With no traces of the original monument found, the corner position was calculated per the ALTA/ACSM Survey for the Willow Creek Wind Farm at the location of ancient fence corner remnants.

Set 5/8"x 30" rebar with 2-1/2" diameter stamped aluminum cap at section corner position. Monument is set flush with the ground.

Set 5/8" rebar with yellow plastic cap stamped "B BESEDA PLS #50800" as references as follows from the section corner:

1. North 67°13'47" East 58.43 feet.
2. South 20°29'57" East 66.07 feet.
3. South 47°20'42" West 69.33 feet.
4. North 29°26'59" West 65.72 feet.

All references are set flush with ground surface.

