


### CORNER RESTORATION

**CORNER:** Corner common to Sections 13 & 24, T2N, R22E, and Sections 18 & 19, T2N, R23E, W.M.

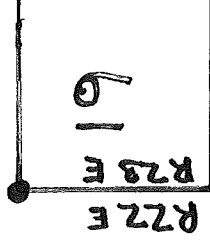

**ORIGINAL SURVEY BY:** David P. Thompson


**CONTRACT NUMBER:** 119

**CONTRACT DATE:** February 15, 1867

**ORIGINAL DESCRIPTION:** Set post in mound of earth with charred stake pits. No bearing objects.

#### RESTORATION BY, STAMP, AND DATE:

Benjamin B. Beseda, PLS 50800  
 Field Work completed July 19, 2011  
 Field Crew Bradley R. Huffmon, PLS 2786  
 And Kelly McCargar, PLS 60179

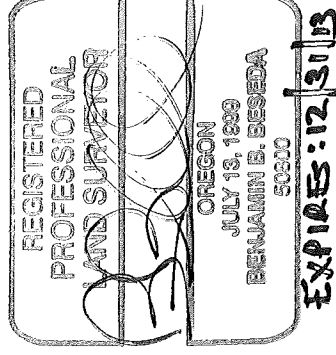

#### EVIDENCE FOUND:

Corner position not reestablished subsequent to GLO Survey. ALTA/ACSM Survey for Willow Creek Wind Farm calculated corner position at fence corner remnants. Field survey verified and accepted this location. No evidence of the original corner was found.

#### DESCRIPTION OF MONUMENTS AND ACCESSORIES SET AND METHODS USED:

With no traces of the original monument found, the corner position was calculated per the ALTA/ACSM Survey for the Willow Creek Wind Farm at the location of ancient fence corner remnants.

Set 5/8"x 30" rebar with 2-1/2" diameter stamped aluminum cap at section corner position. Monument is set flush with the ground.

Set 5/8" rebar with yellow plastic cap stamped "B BESEDA PLS #50800" as references as follows from the section corner:

1. North 67°13'47" East 58.43 feet.
2. South 20°29'57" East 66.07 feet.
3. South 47°20'42" West 69.33 feet.
4. North 29°26'59" West 65.72 feet.

All references are set flush with ground surface.

