


V#15

CORNER RESTORATION

CORNER: 1/4 corner between Sections 27 & 34,
T2N, R23E, W.M.

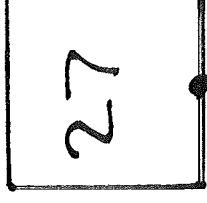

ORIGINAL SURVEY BY: B. J. Pengra


CONTRACT NUMBER: 119

CONTRACT DATE: February 15, 1867

ORIGINAL DESCRIPTION: Set post in mound of earth with charred stake pits. No bearing objects.

RESTORATION BY, STAMP, AND DATE:

Benjamin B. Beseda, PLS 50800
Field Work completed June 24, 2011
Field Crew: Kelly McCargar, PLS 60179

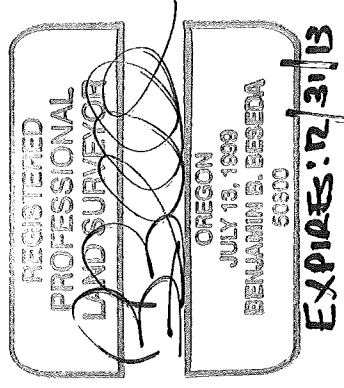

EVIDENCE FOUND:

No evidence of the original corner was found. Corner position falls at the intersection of a road running to the west and a north-south fence. The fences have been built and rebuilt in the same location to the north and south. Cultivation has occurred for many years on both sides of the fence, creating a large berm along the fence. The road has also been in place for a long period of time with field cultivation up to both sides.

DESCRIPTION OF MONUMENTS AND ACCESSORIES SET AND METHODS USED:

With no traces of the original monument found, the corner position was accepted to be at the intersection of the road centerline to the west and the ancient north-south fence.

Set 5/8" x 30" rebar with 2-1/2" diameter stamped aluminum cap at the 1/4 corner position.
Monument is set 0.1 feet +/- out of ground.

The following references being 5/8" x 30" rebar with yellow plastic cap stamped "B BESEDA PLS #50800" were set flush with natural ground and bear as follows from the section corner, unless otherwise noted.

1. North 49°30'49" West 47.12 feet. Set at east end of fence
2. North 27°23'30" West 36.09 feet.
3. North 22°29'35" East 18.97 feet.
4. South 00°10'24" East 24.81 feet. Set in north south fence.

