


V-5

CORNER RESTORATION

CORNER: Corner common to Sections 29, 30, 31 & 32,
T2N, R23E, W.M.

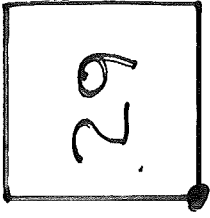

ORIGINAL SURVEY BY: B.J. Pengra


CONTRACT NUMBER: 119

CONTRACT DATE: February 15, 1867

ORIGINAL DESCRIPTION: Set post in mound of earth with charred stake pits. No bearing objects.

RESTORATION BY, STAMP, AND DATE:

Benjamin B. Beseda, PLS 50800
Field Work completed January 6, 2012
Field Crew Bradley R. Huffmon, PLS 2786
And Rob Walker, Survey Tech

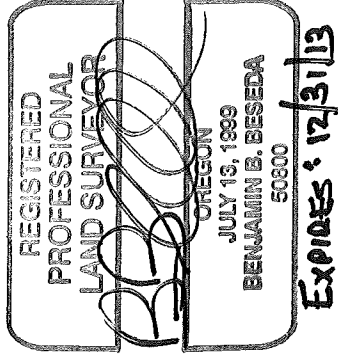

EVIDENCE FOUND:

Corner position falls at the intersection of ancient fences running south, east and west from the corner location. The surrounding ground has been subject to past and/or current cultivation on all sides. No evidence of the original corner was found.

DESCRIPTION OF MONUMENTS AND ACCESSORIES SET AND METHODS USED:

With no traces of the original monument found, the corner position was accepted to be at the intersection of the ancient fences running south, east and west from this location.

Set 5/8" x 30" rebar with 2-1/2" diameter stamped aluminum cap at section corner position.
Monument is set flush with the ground.

Set 5/8" rebar with yellow plastic cap stamped "B BESEDA PLS #50800" as references as follows from the section corner:

1. North 44°39'10" East 40.96 feet.
2. South 89°53'14" East 27.43 feet. Set in east west fence.
3. South 00°58'13" East 28.58 feet. Set in north south fence.
4. South 89°20'29" West 29.15 feet. Set in east west fence.

All references are set flush with ground surface.

