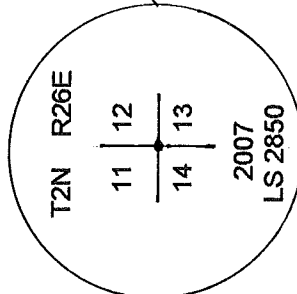
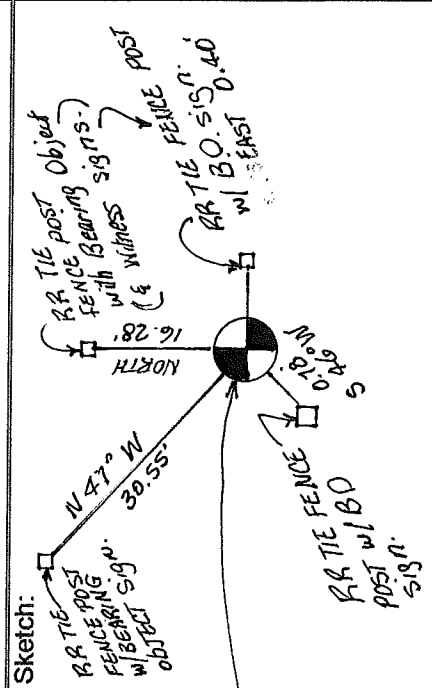
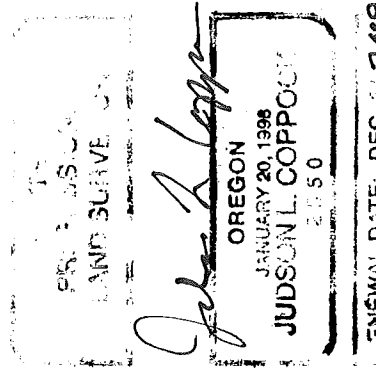


OREGON PUBLIC LAND CORNER REPORT / RESTORATION REPORT
Morrow County Surveyor's Office

SECTION 11 12 14 13	TOWNSHIP 2 NORTH	RANGE R 26 E	
COUNTY: Morrow		DATE	
CORNER DESIGNATION:			
The Corner to Sections 11, 12, 13 and 14, T2N, R26E, W.M., Morrow County, Oregon.			
Previous Renewals / Surveys, etc. See Morrow County Records.			
Monument(s) & Accessories Found: (Condition & Source) Nothing Found.			
Monument Detail:	Sketch:		
			
Monument Set (Procedures and Description): Set 2" I.D. x 30" galvanized pipe with a 2 3/8" Brass Cap.			
New Accessories: From which A RR tie fence post with BO sign bears North 16.28 feet. A RR tie fence post with BO sign bears N 47° West 30.55 feet. A RR tie fence post with witness and bearing object signs bears East 0.40 feet. A RR tie fence post with bearing object signs bear South 46° West 0.78 feet.			
Location & Comments:		Compass Declination:	
Firm / Agency Coppock Surveying		SURVEYOR'S SEAL	
Address: P.O. Box 495 Heppner, OR. 97836			
Party Chief Judson L. Coppock			
Notes			
Witness			

2008 J-21