

**OREGON CORNER RESTORATION FORM**

COUNTY: Morrow    DATE: 03/09/2000

CORNER DESIGNATION: R-21, The Northwest Corner of Section 25, Township 2 South, Range 24 East, W.M.

PREVIOUS RENEWALS/SURVEYS ETC: None. Corner was originally established by Thompson and Pengra, Deputy Surveyors, under Contract No. 119 dated February 15, 1867. Original notes state: "Set stone 16 x 12 x 6 for corner to Sections 23, 24, 25 and 26."

MONUMENT AND ACCESSORIES FOUND: Rock fence jack with old fences extending North, South and West. Several stones of record size are in fence jack, but no marks were discerned. Fence jack was accepted as best remaining evidence of the corner location.

**MONUMENT MARKING DETAIL:**

T2S R24E  
S23 | S24  
S26 | S25  
2000

**MONUMENT SET:**

At a point at the immediate East edge of the fence jack, drove an iron rod to bedrock and surrounded with a 3 1/2 foot diameter mound of stone. An iron rod was used because it made a more stable monument in the rocky ground. Iron rod is capped with a 2 1/2 inch aluminum cap, marked as shown in Monument Marking Detail.

**New Accessories:**


- A 5/8" x 24" iron rod with a yellow plastic cap stamped "OR PLS 1106, WA PLS 17372", 4" above ground, bears N 52° E, 17.8 feet.
- A 5/8" x 24" iron rod with a yellow plastic cap stamped "OR PLS 1106, WA PLS 17372", 2" above ground, bears S 44° E, 24.9 feet.
- A 5/8" x 24" iron rod with a yellow plastic cap stamped "OR PLS 1106, WA PLS 17372", 4" above ground, bears S 55° W, 31.9 feet.
- A 5/8" x 24" iron rod with a yellow plastic cap stamped "OR PLS 1106, WA PLS 17372", 4" above ground, bears N 43° W, 21.7 feet.

All accessories have bearing object tags wired to them. A witness post sign is nailed to fence jack at corner location.


LOCATION AND COMMENTS:    Corner is located at fence intersection, fences running North, South and West.

COMPASS DECLINATION:    18° East                      Surveyor's Seal

Witnesses: Jason Wells  
                  Kevin Snively

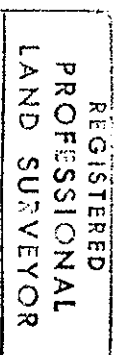

*William R. Wells*

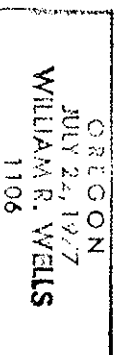

*Renews 6-30-00*