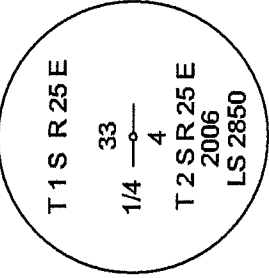
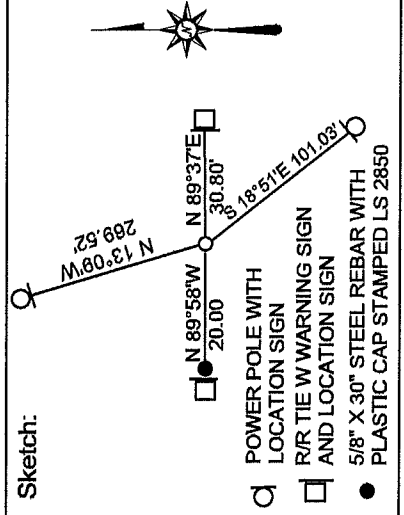
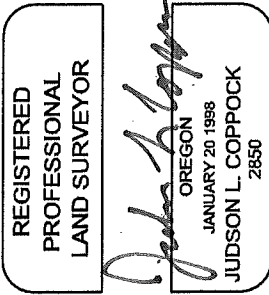


OREGON PUBLIC LAND CORNER REPORT / RESTORATION REPORT

MORROW COUNTY SURVEYOR'S OFFICE

SECTION 1/4 $\frac{33}{4}$	TOWNSHIP $\frac{T 1 S}{T 2 S}$	RANGE R 25 E OF THE WILLAMETTE MERIDIAN
MORROW COUNTY, OREGON		DATE: 1 MAY 2006
CORNER DESIGNATION: 1/4 CORNER COMMON TO SECTION 33 T 1 S, R 25 E AND SECTION 4, T 2 S, R 25 EAST OF THE W.M..		
Previous Renewals / Surveys, etc. GLO CONTRACT 119, 15 FEB 1867 BY THOMPSON AND PENGRA. SET CHARRED STAKE.		
Monument(s) & Accessories Found: (Condition & Source) EAST WEST FENCES ONLY		
Monument Detail: 	Sketch: 	(Please check one) <input type="checkbox"/> Condition Report Only <input checked="" type="checkbox"/> Not Found <input type="checkbox"/> Renewed <input type="checkbox"/> Unrecorded <input checked="" type="checkbox"/> Surveyed In <input checked="" type="checkbox"/> Referenced Out
Monument Set (Procedures and Description): SET 2 3/8" BRASS CAP STAMPED AS SHOWN ON A 2" ID X 30" GALV. STEEL PIPE FLUSH WITH SURFACE OF CLARKS CANYON ROAD. SURVEYED AND COMPUTED IN CONJUNCTION WITH A PARTITION PLAT FOR MUNKERS.		
New Accessories: POWER POLE N 13°09' W 269.52I TO FACE OF BEARING OBJECT SIGN. R/R TIE FENCE POST N 87°37' E 30.80' TO FACE OF BEARING OBJECT SIGN. POWER POLE S 18°51' E 101.03' TO FACE OF BEARING OBJECT SIGN. 5/8" X 30" STEEL REBAR WITH PLASTIC CAP STAMPED LS 2850, N 89°58' W 20.00' GUARDED WITH "T" POST AND SIGN.		
Location & Comments: IN PAVEMENT OF CLARKS CANYON ROAD.		Compass Declination: NOT DETERMINED
Firm / Agency COPPOCK SURVEYING PO Box 495 HEPNER, OR 97836	SURVEYOR'S SEAL REGISTERED PROFESSIONAL LAND SURVEYOR	
Party Chief JUDSON L. COPPOCK LS 2850		
Notes SHANNON BENEFIT	RENEWAL DATE: DEC. 31, 2007	
Witness	(Empty space for witness signature)	

2-4