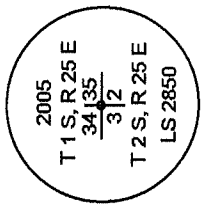
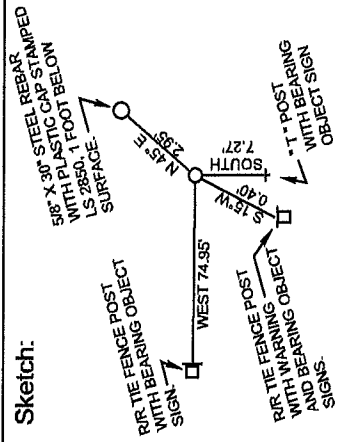



OREGON PUBLIC LAND CORNER REPORT / RESTORATION REPORT
MORROW COUNTY SURVEYOR'S OFFICE

SECTION 34 35 3 2	TOWNSHIP T 1 S T 2 S	RANGE R 25 E	
MORROW COUNTY, OREGON		DATE: 3 MAY 2006	
CORNER DESIGNATION:			(Please check one)
SECTION CORNER COMMON TO SECTIONS 34 AND 35, T 1 S, R 25 E AND SECTIONS 3 AND 2, T 2 S, R 25 E., WILLAMETTE MERIDIAN, MORROW COUNTY, OREGON.			<input type="checkbox"/> Condition Report Only
			<input checked="" type="checkbox"/> Not Found
			<input type="checkbox"/> Renewed
			<input type="checkbox"/> Unrecorded
			<input type="checkbox"/> Surveyed In
			<input checked="" type="checkbox"/> Referenced Out
Previous Renewals / Surveys, etc.			
GLO CONTRACT 119, 15 FEB. 1867 BY THOMPSON AND PENGRA. POST AND CHARRED STAKE SET.			
Monument(s) & Accessories Found: (Condition & Source)			
FENCE CORNER ONLY			
Monument Detail:	Sketch:		
2 3/8" BRASS CAP STAMPED AS SHOWN ON A 2" ID X 30" FLARED STEEL PIPE.			
Monument Set (Procedures and Description):			
SET BRASS CAP STAMPED AS SHOWN AT FENCE CORNER ACCEPTED AS THE BEST REMAINING EVIDENCE OF ORIGINAL CORNER LOCATION.			
New Accessories:			
PLACED BEARING OBJECT ON EXISTING R/R TIE FENCE POST WHICH BEARS WEST 74.95'. PLACED WARNING AND BEARING OBJECT SIGN ON EXISTING R/R TIE FENCE POST WHICH BEARS S 15° W 0.40'. SET * T * POST WITH BEARING OBJECT SIGN SOUTH 7.27'. SET A 5/8" X 30" STEEL REBAR WITH A PLASTIC CAP STAMPED LS 2850 N 45° E 2.95' AND 1 FOOT BELOW SURFACE.			
Location & Comments:		Compass Declination:	
AT FENCE CORNER AND SURROUNDED BY CRP AND CROW LAND. NO ROAD ACCESS.		NOT DETERMINED	
Firm / Agency		SURVEYOR'S SEAL	
COPPOCK SURVEYING PO Box 495 HEPPNER, OR 97836			
Party Chief			
JUDSON L. COPPOCK LS 2850			
Notes		SHANNON BENEFIT	
Witness			
<small>RENEWAL DATE: DEC. 31, 2007</small>			