

# OREGON CORNER RESTORATION FORM

COUNTY: Morrow DATE: 5/31/15

CORNER DESIGNATION: The Northwest Quarter Corner of Section 12, Township 2 South, Range 25 East, E-21.

PREVIOUS RENEWALS/SURVEYS ETC.: Corner originally established by Thompson and Pengra under Contract 119, dated July 15, 1867, notes state: Set a stone 15 x 10 x 8 inches as corner to Sections 1, 2, 11 & 12.

MONUMENT AND ACCESSORIES FOUND: None. Corner point falls in a North-South fence line at the projected intersection of a field line from the West.

## MONUMENT MARKING DETAIL:

T2S R25E

S2|S1

S11|S12

2015

PLS 1106

## MONUMENT SET:

A stone is of record but the area East of the fence has been farmed and is now old CRP. Area to the West of fence appears to have been farmed in the past. I probed extensively for a stone at the corner point and North and South of the corner point in the North-South fence line, but did not recover the stone. I held a point in the North-South fence, at the projected intersection of a field line from the West as best remaining evidence of the original corner. At this point, all four wires of the N-S fence have been cut and spliced, as if a fence could have extended East or West in the past. I set a 2 3/8" brass cap on a 1 1/4" x 30" galvanized iron pipe, 28" in the ground on the West side of the North-South fence, stamped as shown in "Monument Marking Detail".

## New Accessories:

A 5/8" x 24" rebar with a yellow plastic cap stamped "OR PLS 1106, WA PLS 17372" bears North, 29.8 feet. (In fence line).

A 5/8" x 24" rebar with a green plastic cap stamped "OR PLS 1106, WA PLS 17372" bears North, 62.3 feet. (In fence line).

A 5/8" x 24" rebar with a green plastic cap stamped "OR PLS 1106, WA PLS 17372" bears South, 30.4 feet. (In fence line).

A 5/8" x 24" rebar with a yellow plastic cap stamped "OR PLS 1106, WA PLS 17372" bears South, 65.7 feet. (In fence line).

Set steel fence post 1 1/2 feet North of corner with Witness sign attached. Wired bearing object signs to the rebar accessories.

LOCATION AND COMMENTS: In North-South fence line, at projected intersection of field line from the West. Corner about 100 feet East of Meadow Brook Road.

OREGON STATE PLANE COORDINATES, North Zone, International Feet, NAD 83-2011, Epoch 2010.00:

N = 638401.32

E = 8418378.30

FIRM: Wells Surveying

P.O. Box 1696

Pendleton, OR 97801

COMPASS DECLINATION: 18° East

Surveyor's Seal

Witnesses: William Wells, PLS

**RECEIVED BY**

Morrow County Surveyor


\2S25E21

Date: 6-30-2015


Rec'd By: SKH

No.: 2015-1743C

Folder No.: 2S25E21

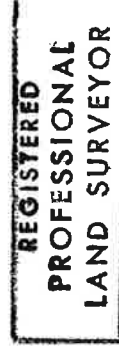

*Will. R. Wells*

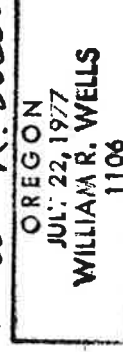

*renews 6-30-16*