

OREGON CORNER RESTORATION FORM:

36 | 31 | 1S  
 SECTION 16 TOWNSHIP 2S RANGE 25E 26E  
 COUNTY MORROW DATE JUNE 1, 2001

CORNER DESIGNATION: **A-1**

T 1 S  
36 | 31 | R 26 E  
 1 | 6  
 T 2 S

CONDITION REPORT ONLY  
 NOT FOUND  
 RENEWED  
 UNRECORDED  
 SURVEYED IN  
 REFERENCED


PREVIOUS RENEWALS, SURVEYS, ETC.

Original 1867 GLO Survey by B.J. Pengra. He drove charred stake and raised mound. In a survey for Schmidt family Enterasas dated 9/14/00 I found a 7"x14"x28" Stone along side of the SW corner of a well-constructed Rock Jack with fences running North and South & a fence running East from this Rock Jack. I used this stone after running 1 mile North to a well-defined stone mound & West 2 miles to a good fence intersection.

MONUMENTS AND ACCESSORIES FOUND: Condition and Source

Found as noted above, except the fence to the East has been removed. for about 1/4 mile. The Rock Jack and Stone found in 2000 were not disturbed.

MONUMENT DETAIL:

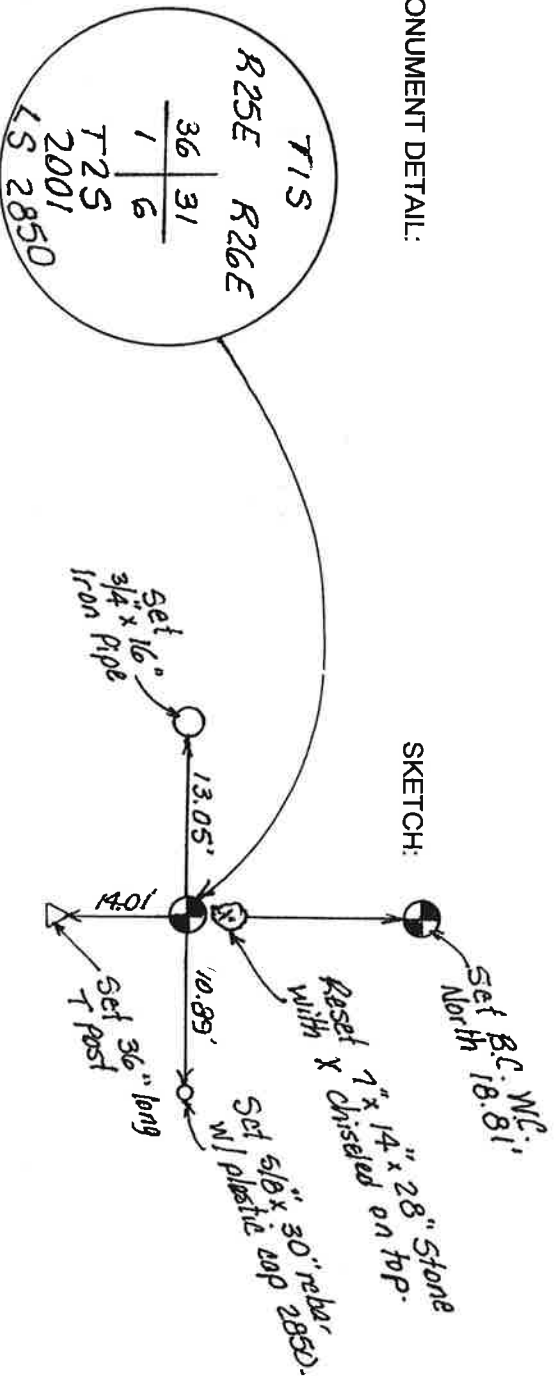

NEW MONUMENT SET (PROCEDURES AND DESCRIPTION):

Although I had accepted the found stone as the Township corner for the Schmidt Survey, I did an additional GPS Search and Survey, South along the Range line for 3 miles. I could not find a record of where this 7 x 14 x 28" Stone came from, it was not set as a foundation for the Rock Jack, it was set vertical & about 2 ft. deep. It fits the record & occupation lines. I moved the Stone North & chiseled an X on top 1.07 ft from Brass Cap. I set a 2 3/8" Brass Cap on a 1" x 30" galvanized pipe at find stone location.

NEW ACCESSORIES SET:

1. Set a 2 3/8" Brass Cap on a 1" x 30" galvanized pipe Witness Corner, North 18.81 feet.
2. Set a 36" long T Post, South 14.01 feet.
3. Set a 5/8" x 30" steel rebar with a plastic cap marked LS 2850, East 10.89 feet.
4. Set a 3/4" x 16" galvanized pipe, West 13.05 feet.
5. Reset the 7 x 14 x 28" Stone, I marked with an X chiseled on top, North 1.07 ft.

LOCATION AND COMMENTS:

COMPASS DEC. Not Observed SURVEYOR'S SEAL

FIRM: COPPOCK SURVEYING

P.O. BOX 340  
 HERMISTON, OR 97838  
 541-567-6974

RECEIVED BY

Morrow County Surveyor

Date 8-01-01

Rec'd By RVA

No. C-1314-AA

PARTY CHIEF: J COPPOCK  
 NOTE KEEPER: S. BENEFIT  
 WITNESS: S. BENEFIT

