

OREGON CORNER RESTORATION FORM:

SECTION 13 | 19 | TOWNSHIP 25 | RANGE 25E | 26E
COUNTY MORROW , DATE JUNE 1, 2001

CORNER DESIGNATION: N-1

R25E | R26E
13 | 18
24 | 19
T 25

CONDITION REPORT ONLY
 NOT FOUND
 RENEWED
 UNRECORDED
 SURVEYED IN
 REFERENCED *Control Point Only*

PREVIOUS RENEWALS, SURVEYS, ETC.

*Original 1867 GLO Survey by B.J. Pengra.
He drove a charred stake and raised a mound.*

MONUMENTS AND ACCESSORIES FOUND: Condition and Source

*Found a Pk. Nail set in line with a fence South and in Eastbound side
of a County Road.
Found Pk. Nail is 7.50 feet South of Pk. Nail I set at E of pavement.
I found no record of the found Pk. Nail.*

MONUMENT DETAIL:

SKETCH:

NEW MONUMENT SET (PROCEDURES AND DESCRIPTION):

*Set a Pk. Nail in line with fence to South on E of Pavement of
County Road.*

NEW ACCESSORIES SET:

LOCATION AND COMMENTS:

*Without running farther
South I don't know for sure
but if would appear that
the fence line is on the
Range line and the E
of the pavement is 25
to 35 North of the
Section Corner.*

COMPASS DEC. Not Observed

SURVEYORS SEAL

FIRM: COPPOCK SURVEYING

P.O. BOX 340
HERMISTON, OR 97838
541-567-6974

PARTY CHIEF: J COPPOCK
NOTE KEEPER: S. BENEFIT
WITNESS: S. BENEFIT


RECEIVED BY

Morrow County Surveyor

Date 08-01-01

Rec'd By RUM

No. C-1314-AA

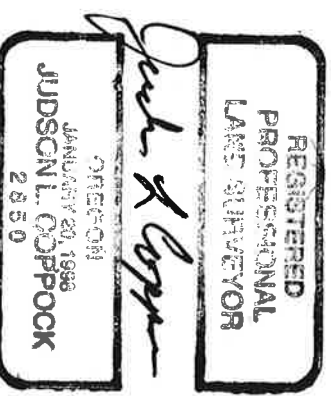

RENEWAL DATE: DEC. 31/01