

OREGON CORNER RESTORATION FORM

Section 23 Township 2S Range 26E
 County Morrow Date: September 11, 2017

Corner Designation: 2S26P17

Condition Report Only
 Not found
 Remonumented
 Unrecorded
 Surveyed in
 Referenced out


Common quarter corner to sections 22 and 23, T2S, R26E, W.M., Morrow County, Oregon.

Previous Renewals / Surveys, etc.

Corner originally set by B.J. Pengra under contract No. 119 dated February 15, 1867. His record reads: Set a stone, 16 x8 x 6 inches as 1/4 section corner. In 1912, D.V.S. Reid found the "rock" and rocks of the stone mound somewhat scattered. Reid reset the stone & rebuilt the mound. He also established 4 references as follows: NE 10 links, a deposit of broken clear glass. NW 10 links, a 3/4" iron pipe 6 inches long. SW 10 links, a deposit of fine stone coal. SE 10 links, a deposit of broken brown glass. In survey folder 395, James Buisman called for a point for the 1/4 corner but does not indicate what he held for that point. In partition plat 2005-6 Judson Coppock set a brass cap by single proportion.


Monument and Accessories found: (condition and source)

The brass cap by Coppock badly out of position. The iron pipe by Reid that agrees with the position held by Buisman. A small mound of small stones at the corner point but the original stone was not present.

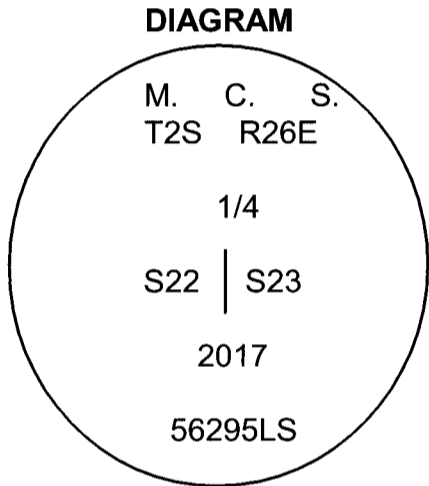

⊙ = Set brass cap
 • = Rebar reference

Brass cap and guard post by Coppock.

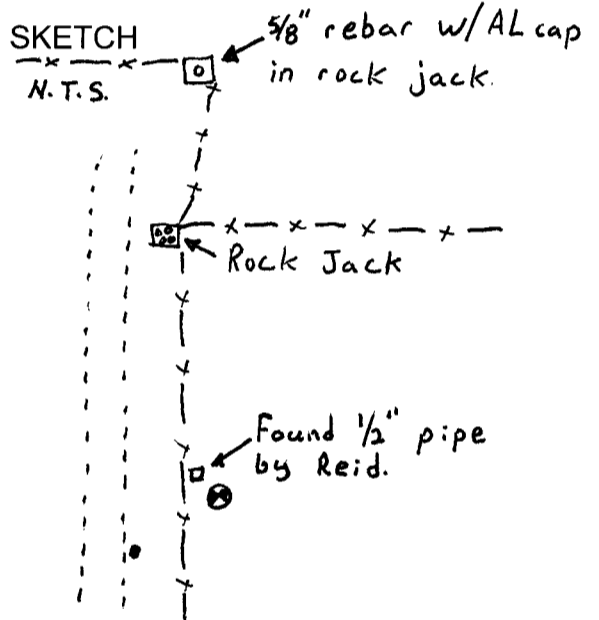

MONUMENT (S) AND ACCESSORIES SET (Procedures and Description)

At the position of the original corner determined by Reid's pipe and held by Buisman, I set a 1 1/2" x30" galvanized iron pipe with a 2 3/8" brass cap stamped as shown in the diagram above 24" in the ground to bedrock.

For references, I set one 5/8" by 24" rebar with a 1.25" orange plastic cap stamped WTS and 56295LS as described below:

- an iron rebar bears S50°34'53"W, 33.33 feet in the edge of a dirt road;
- the 1/2" pipe by Reid bears N67°50'28"W, 6.60 feet;
- a 5/8" iron rebar with 2" aluminum cap rebar bears N0°03'00"W, 189.52 feet in a rock jack;
- the brass cap by Coppock bears N63°27'16"W, 61.79 feet;

The monument and references were tied using a Trimble R7/R8 RTK GPS system.

Location and comments

Compass Declination

RECEIVED BY:
 Morrow County Surveyor
 Date: 9-21-2017
 Rec'd By: S.K.H.
 No. 2S26P17
 Survey No. 2017-1806D

Firm / Agency
 Witness Tree Surveying
 Address
 P.O. Box G
 Pilot Rock, OR 97868

Surveyor's Seal

**REGISTERED
 PROFESSIONAL
 LAND SURVEYOR**

Stephen K. Haddock

OREGON
 JULY 9, 2001
 STEPHEN K. HADDOCK
 56295LS

RENEWS: 6-30-19