

P. 21

OREGON CORNER RESTORATION FORM

Section 23 Township 2S Range 26E
County Morrow Date: April 25, 2008

Corner Designation: 2S26P21

Condition Report Only
Not found _____
Remonumented x
Unrecorded _____
Surveyed in _____
Referenced out x

Common quarter corner to sections 23 and 24, T2S, R26E, W.M., Morrow County, Oregon.


Previous Renewals / Surveys, etc.

Corner originally set by David P. Thompson under contract No. 119 dated February 15, 1867. His record reads: Set stone, 14 x 12 x 8 as 1/4 section corner. Morrow County Partition Plat 2005-6 shows "computed location only"

Monument and Accessories found: (condition and source)


The original stone, in place but tipped to one side, appears to have a part of the "4" on the side and an "x" on top. This stone is 9 feet from the "computed location" shown on the partition plat. The surface (about 1/16th" thick) of the basalt stone is fairly crumbly and scrubbed off when cleaned with the wire brush.

DIAGRAM

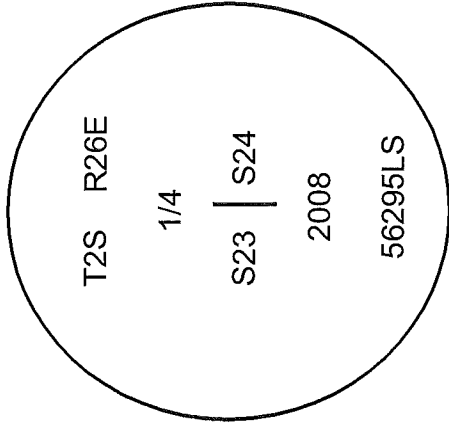

- ⊗ = Brass Cap
- = Rebar Reference

SKETCH

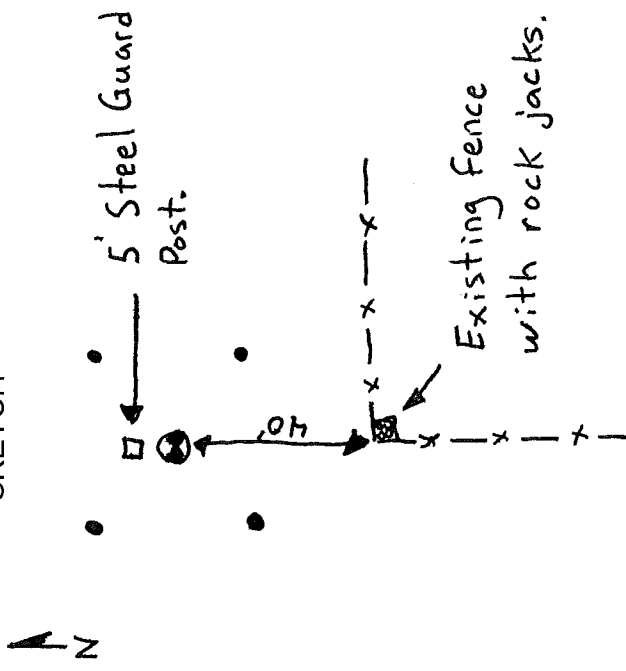

MONUMENT (S) AND ACCESSORIES SET (Procedures and Description)

I set a 1 1/2" x 30" galvanized iron pipe with a 2 1/4" brass cap stamped as shown in the diagram above at the position of the original stone. I buried the stone along side NE from the pipe.

For references, I set four 5/8" by 24" rebars with 1.25" orange plastic caps stamped WTS and 56295LS as described below:

- an iron rebar bears N47°58'45"E, 31.24 feet;
- an iron rebar bears N38°29'48"W, 25.93 feet;
- an iron rebar bears S49°19'41"W, 28.72 feet;
- an iron rebar bears S51°00'06"E, 29.16 feet;

The monument and references were tied using a Trimble R7/R8 RTK GPS system.

Location and comments

Compass Declination

Surveyors Seal

RECEIVED BY:

Morrow County Surveyor
Date: May 28 2008
Rec'd By: SKB
No. P-21

Firm / Agency
Witness Tree Surveying
Address
P.O. Box G
Pilot Rock, OR 97868
Party Chief
Stephen K, Haddock

REGISTERED
PROFESSIONAL
LAND SURVEYOR

Stephen K. Haddock

OREGON
JULY 9, 2001
STEPHEN K. HADDOCK
56295LS

RENEWAL DATE 6-30-09