

R-17

OREGON CORNER RESTORATION FORM

Section 26 Township 2S Range 26E
County Morrow Date: May 24, 2008

Corner Designation: 2S26R17


Corner to sections 22, 23, 26, and 27, T2S, R26E,
W.M., Morrow County, Oregon.

Previous Renewals / Surveys, etc.


Corner originally set by David P. Thompson under contract No. 119 dated February 15, 1867. His record reads: Set stone 14x12x6 as corner to sections 22, 23, 26 & 27. Dave Krumbein, in survey C-97-K established a position for this corner by proportion but set no monument. His position has subsequently been used in surveys C-146-K, C-221-K, the Plat of Ployhar Estates and Partition Plat 2005-06.

Monument and Accessories found: (condition and source)
None.

DIAGRAM

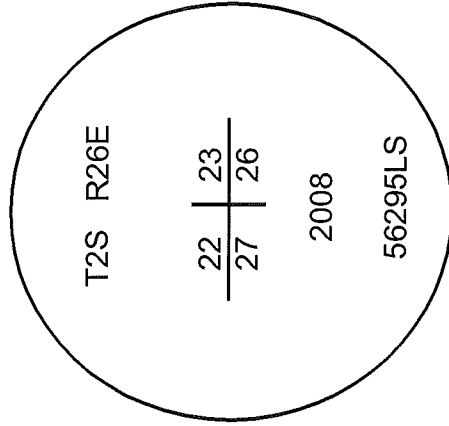

SKETCH

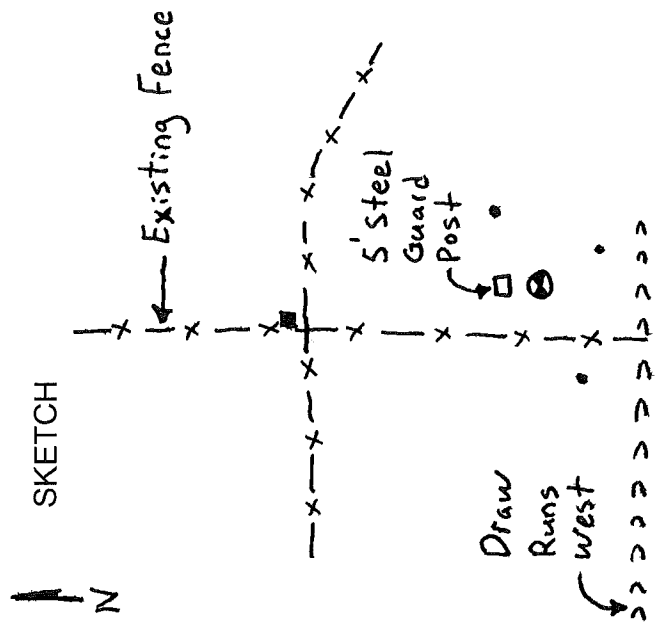

● = Brass Cap

• = Rebar Reference

■ = Rebar-Origin unknown

MONUMENT (S) AND ACCESSORIES SET (Procedures and Description)

I computed the corner location from ties to the monuments set under the surveys described above and at the corner point I set a 5/8"x24" iron rebar 24" in the ground. Over this I set a 1 1/2" by 30" galvanized iron pipe with a 2 1/4" brass cap stamped as shown in the diagram above flush with the surface of the ground and made a small collar of stone around the cap. I set a 5' steel guard post with a Morrow County monument sign approximately 1 foot north of the cap.

For references, I set three, 5/8" by 24" rebars with 1 1/8" orange plastic caps attached, stamped WTS and 56295LS as described below:

an iron rebar bears N41°30'19"E, 41.64 feet;

an iron rebar bears S48°29'56"E, 31.49 feet;

an iron rebar bears S44°34'19"W, 47.91 feet;

a 5/8" iron rebar of unknown origin bears N02°45'30"W 213.96 feet on the north side of a four way, fence intersection.

The monument was set and the references were tied using a Trimble R7/R8 RTK GPS.

Location and comments

Compass Declination

Surveyors Seal

RECEIVED BY:

Morrow County Surveyor

Date: MAY 28 2008

Rec'd By: SKB

No. R-17

Firm / Agency
Witness Tree Surveying
Address

P.O. Box G
Pilot Rock, Or. 97868
Party Chief
Stephen K, Haddock

REGISTERED
PROFESSIONAL
LAND SURVEYOR

Stephen K. Haddock

OREGON
JULY 9, 2001
STEPHEN K. HADDOCK
56295LS

RENEWAL DATE 6-30-09