

R-21

OREGON CORNER RESTORATION FORM


Section 26 Township 2S Range 26E
County Morrow Date: April 25, 2008

Corner Designation: 2S26R21
Corner to sections 23, 24, 25, and 26, T2S, R26E,
W.M., Morrow County, Oregon.
Previous Renewals / Surveys, etc.
Corner originally set by David P. Thompson under contract No. 119 dated February 15, 1867. His
record reads: Set charred stake in raised mound as corner to sections 23, 24, 25 & 26. Morrow
County Partition Plat 2005-6 calls for "computed location only".


Condition Report Only
Not found
Remonumented
Unrecorded
Surveyed in
Referenced out

Monument and Accessories found: (condition and source)
A long standing north-south fence line running along the section line.

DIAGRAM

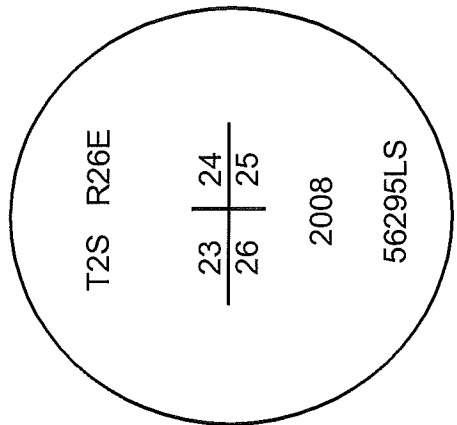

SKETCH

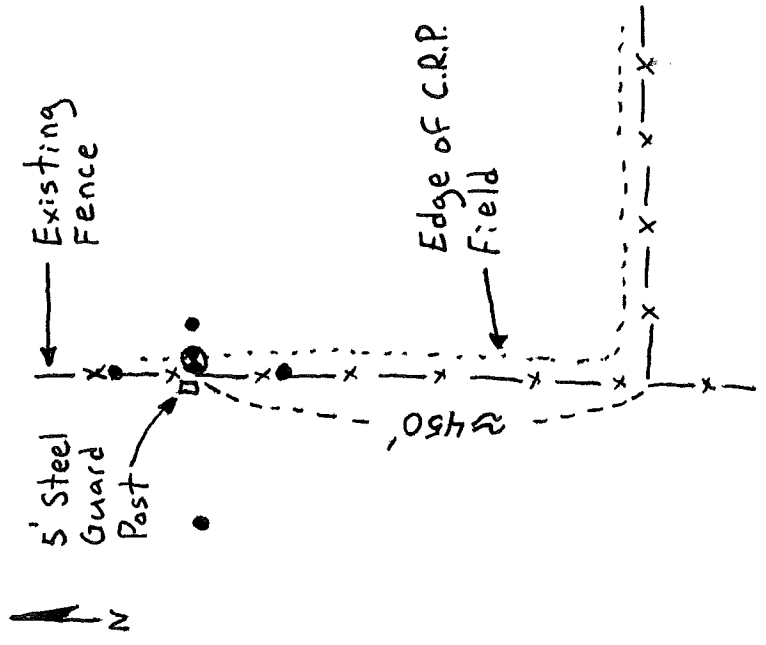

MONUMENT (S) AND ACCESSORIES SET (Procedures and Description)
I proportioned the latitude and held the long standing fence for the departure. At the corner point
I set a 1 1/2" x 30" galvanized iron pipe with a 2 1/4" brass cap stamped as shown in the diagram
above.

For references, I set four, 5/8" by 24" rebars with 1 1/8" orange plastic caps attached, stamped
WTS and 56295LS approximately 6" below the surface as described below:
an iron rebar bears N00°26'12"E, 34.77 feet under the existing fence;
an iron rebar bears S01°35'30"W, 31.09 feet under the existing fence;
an iron rebar bears S88°02'11"E, 8.62 feet 2, feet below the surface;
an iron rebar bears S87°04'36"W, 45.21 feet;

The monument was set and the references were tied using a Trimble R7/R8 RTK GPS.

Location and comments
Compass Declination
Surveyors Seal
Firm / Agency
Witness Tree Surveying
Address
P.O. Box G
Pilot Rock, Or. 97868
Party Chief
Stephen K, Haddock
RECEIVED BY:
Morrow County Surveyor
Date: MAY 28 2008
Rec'd By: SKB
No. R-21

REGISTERED
PROFESSIONAL
LAND SURVEYOR

Stephen K. Haddock

OREGON
JULY 9, 2001
STEPHEN K. HADDOCK
56295LS

RENEWAL DATE 6-30-09