


CERTIFIED RECORD OF LAND CORNER MONUMENTATION

7-17

History of original corner establishment:


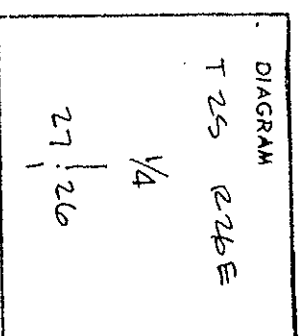


Description of corner evidence found:

I found the 2 1/2 inch diameter pipe of record.

Description of monument and accessories I established to perpetuate the original location of this corner

I set a 2 1/2 inch diameter brass cap on a 2 1/2 inch diameter iron pipe 30 inches long. I set the pipe 22 inches in the ground.

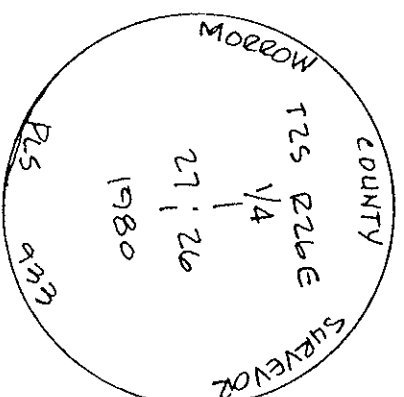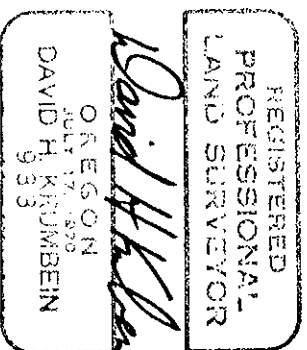

Office of County of
State of , I hereby certify that the within instrument was filed in this office
for record on the day of
(COUNTY OFFICIAL) by (DEPUTY)

RECEIVED BY
Morrow County Surveyor
Date 4-25-80
Rec'd By MST
No. #289-K

Corresponding drawing