

T-19

**OREGON CORNER RESTORATION FORM**

Section 26 Township 2S Range 26E  
County Morrow Date: May 24, 2008

Corner Designation: 2S26T19

Center 1/4 corner to Section 26, T2S, R26E W.M.  
Morrow County, Oregon.


Condition Report Only  
Not found  
Remonumented  
Unrecorded  
Surveyed in     
Referenced out   

Previous Renewals / Surveys, etc.


I found no record of any previous establishment of a monument at this corner point.

Monument and Accessories found: ( condition and source )  
None.

**DIAGRAM**

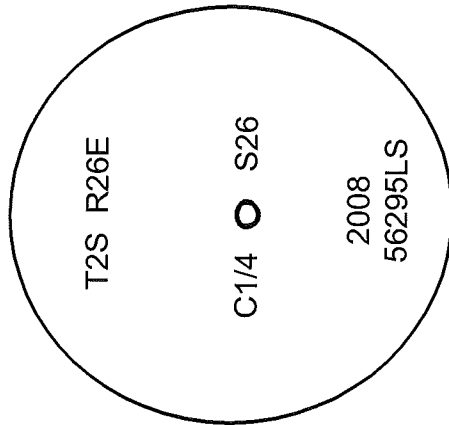

⊙ = Al. Cap  
● = Rebar Reference

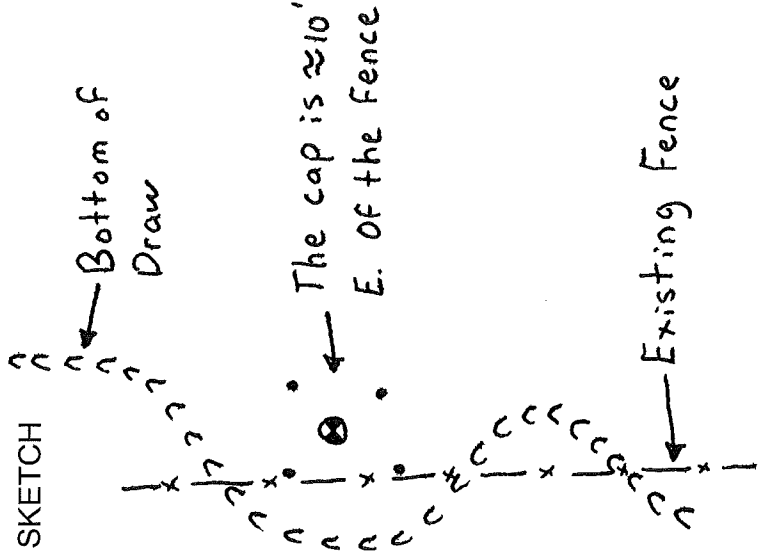

**MONUMENT (S) AND ACCESSORIES SET (Procedures and Description)**

I set a 1" x 24" iron rebar with a 2" aluminum Cap stamped as shown above flush with the surface of the ground at the calculated center 1/4 location.

For references, I set four 5/8" by 24" iron rebars with 1 1/8" orange plastic caps stamped WTS and 56295LS as described below:  
a rebar bears N59°08'03"E, 35.11 feet;  
a rebar bears N18°19'47"W, 36.43 feet under the existing fence;  
a rebar bears S14°51'19"W, 40.37 feet under the existing fence;  
a rebar bears S34°31'10"E, 37.59 feet;

The monument was set and references tied using a Trimble R7/R8 RTK GPS.

Location and comments

Compass Declination

Surveyors Seal

RECEIVED BY:  
Morrow County Surveyor  
Date: MAY 28 2008  
Rec'd By: SKB  
No. T-19

REGISTERED  
PROFESSIONAL  
LAND SURVEYOR

*Stephen K. Haddock*

OREGON  
JULY 9, 2001  
STEPHEN K. HADDOCK  
56295LS

RENEWAL DATE 6-30-09