


CERTIFIED RECORD OF LAND CORNER MONUMENTATION

113

History of original corner establishment:


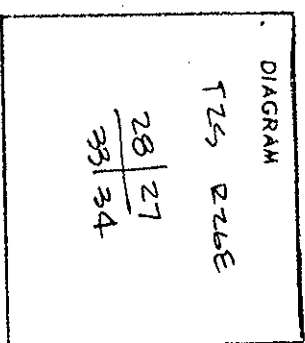


Description of corner evidence found:

I found a 5/8 inch iron pin and cap of record.

Description of monument and accessories established to perpetuate the original location of this corner

I set a 2 1/2 inch in diameter brass cap on a 2 1/2 inch diameter iron pipe 30 inches long. I set the pipe 18 inch in ground and built a stone mound around the cap.

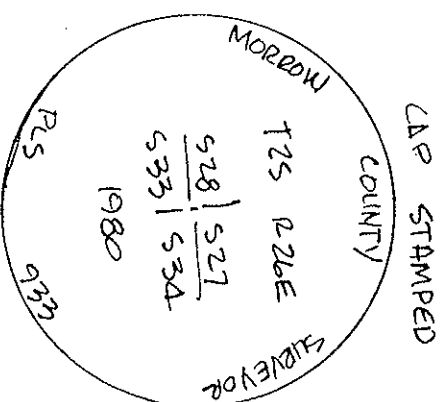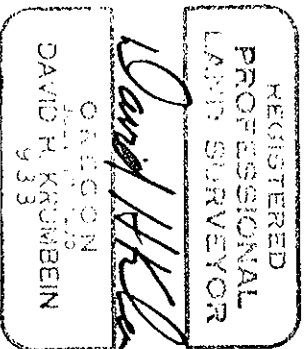

Office of County of
State of, I hereby certify that the within instrument was filed in this office
for record on the day of
..... (COUNTY OFFICIAL) by (DEPUTY)

RECEIVED BY

Morrow County Surveyor

Date 4-25-80

Rec'd By DMST

No. # 289-K

GPO 796-333
concerning
drawing