

OREGON CORNER RESTORATION FORM

Section 34 Township 2S Range 26E
 County Morrow Date: August 25, 2017

Corner Designation: 2S26V13

Condition Report Only
 Not found
 Remonumented
 Unrecorded
 Surveyed in
 x Referenced out


Corner to sections 27, 28, 33, and 34, T2S, R26E,
 W.M., Morrow County, Oregon.

Previous Renewals / Surveys, etc.

Corner originally set by B.J. Pengra under contract No. 119 dated February 15, 1867. His record reads: Set charred stake in raised mound as corner to sections 27, 28, 33 & 34. In 1974 Wayne Harris stated he found a 5/8" iron pin stamped SC 27-28-33-34. (See folder 1805.) In 1977 Dave Krumbein stated he found a 5/8" pin. (See folder 347) In 1980 Mr. Krumbein remonumented the 5/8" pin with a brass cap. (See folder 429.)

Monument and Accessories found: (condition and source)

The brass cap set in 1980 by Mr. Krumbein somewhat loose in a 3' diameter mound of stone.
 The monument projects 12 inches above the mound.

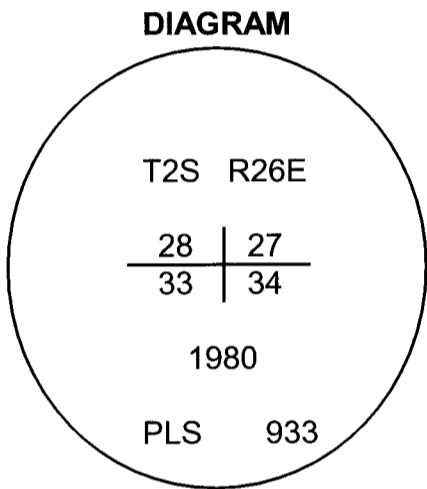

= Brass Cap in Stone Mound
 = Rebar Reference

MONUMENT (S) AND ACCESSORIES SET (Procedures and Description)

I held the position of the found brass cap as it was set by Mr. Krumbein when he was the county surveyor.

For references, I set four, 5/8" by 24" rebars with 1 1/8" orange plastic caps marked WTS and 56295LS as follows:

- an iron rebar bears N67°13'42"W, 34.29 feet;
- an iron rebar bears N70°48'10"E, 87.30 feet;
- an iron rebar bears S14°55'03"E, 43.38 feet;
- an iron rebar bears S36°30'04"W, 148.94 feet;

The monument and references were tied using a Trimble R7/R8 RTK GPS.

Location and comments

Compass Declination

Surveyor's Seal

RECEIVED BY:
Morrow County Surveyor
 Date: 9-21-2017
 Rec'd By: S.K.H.
 No. 2526V13
 Survey No. 2017-1806D

Firm / Agency
 Witness Tree Surveying
 Address
 P.O. Box G
 Pilot Rock, Or. 97868

**REGISTERED
 PROFESSIONAL
 LAND SURVEYOR**

Stephen K. Haddock

OREGON
 JULY 9, 2001
 STEPHEN K. HADDOCK
 56295LS

RENEWS: 6-30-19