


CERTIFIED RECORD OF LAND CORNER MONUMENTATION

History of original corner establishments:


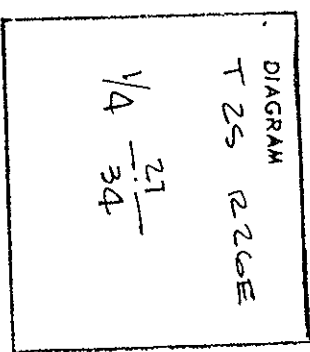


Description of corner evidence found:

I found the 5/8 inch diameter iron pin of record.

Description of monument and accessories | established to perpetuate the original location of this corner

I set a 2 1/2 inch diameter brass cap on a 2 1/2 inch diameter iron pipe 30 inches long. I set the pipe 24 inches in the ground.

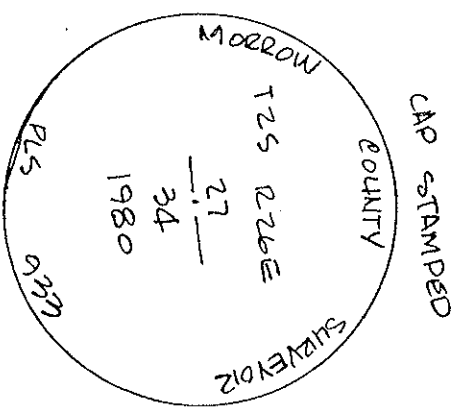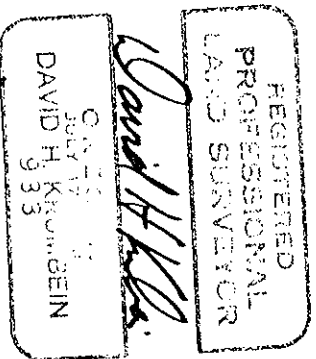

Office of ..... County of .....  
State of ..... I hereby certify that the within instrument was filed in this office  
for record on the ..... day of .....  
..... (COUNTY OFFICIAL) by ..... (DEPUTY)

RECEIVED BY  
Morrow County Surveyor  
Date 4-25-80  
Rec'd By MMBI  
No. # 289-K

GPO 796-371  
