


CERTIFIED RECORD OF LAND CORNER MONUMENTATION

HISTORY OF ORIGINAL CORNER ESTABLISHMENT:

THE SUBDIVISION OF T. 2 S., R. 26 E., W.M. WAS ORIGINALLY SURVEYED BY B. J. PENGRA DEPUTY SURVEYOR, UNDER GENERAL LAND OFFICE CONTRACT NO. 119, APPROVED AUGUST 3, 1867 BY E. L. APPLIGATE SURVEYOR GENERAL OF OREGON. THE W 1/16 CORNER OF SECTIONS 26 & 35 WAS NOT SET AS PART OF THIS CONTRACT.

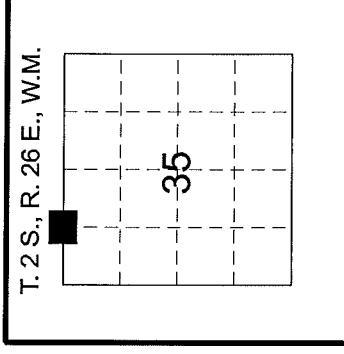


THE W 1/16 CORNER OF SECTIONS 26 & 35 WAS REFERENCED AS PART OF THE MAY 29, 1905 SURVEY DONE BY THE CITY OF HEPPNER SURVEYOR D. V. S. REID CALLED DAY'S ADDITION. THE DEED TO DAYS ADDITION DESCRIBES THE SAID MONUMENT AS AN "IRON SASH WEIGHT SET 14 INCHES INTO THE GROUND WITH A BASALT ROCK 34X24X10 INCHES ALONG SIDE ON THE EAST SIDE OF SAID SASH WEIGHT WITH TOP OF ROCK SET AT SURFACE OF GROUND."

THE W 1/16 CORNER OF SECTIONS 26 & 35 WAS PERETUATED WITH A 2" DIA. X 28" GALVANIZED PIPE WITH A 2 1/2" DIA. BRASS DISK OVER A 1" IRON PIN AND A 2" IRON SASH WEIGHT, NOTED ON REMONUMENTATION SURVEY C-256-K FOR MORROW COUNTY BY DAVE KRUMBEIN.

DESCRIPTION OF CORNER EVIDENCE FOUND:

FOUND 2 1/2" DIA. BRASS DISK MARKED "MORROW COUNTY SURVEYOR, T2S R26E, W 1/16, 26 35, 1980, PLS 933", SAID MONUMENT WAS REFERENCED BY ODOT AND DESTROYED DURING CONSTRUCTION OF THE OR74: WILLOW CREEK BRIDGE - MORROW COUNTY FAIRGROUNDS (HEPPNER) PROJECT IN 2009. THE EXISTING ROADWAY WAS EXCAVATED TO A DEPTH OF APPROXIMATELY 15".

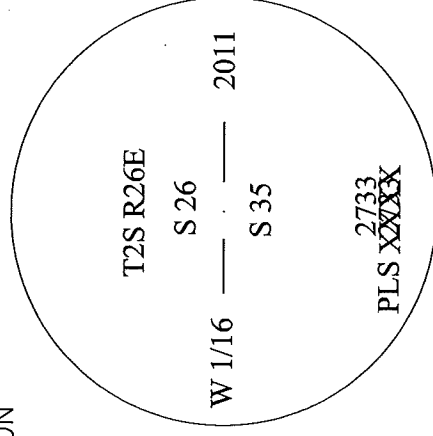

DESCRIPTION OF MONUMENT AND ACCESSORIES I ESTABLISHED TO PERPETUATE THE ORIGINAL LOCATION OF THIS CORNER:

AT THE CORNER POSITION, SET A 2" DIA. X 28" GALVANIZED PIPE WITH A 2 1/2" DIA. BRASS DISK IN A MONUMENT BOX IN STANBURY ST. SET TWO REFERENCE AS DESCRIBED BELOW:

FROM WHICH; I ESTABLISHED THE FOLLOWING REFERENCES:

A 1" DIA. X 1.5" BRASS DISK, MARKED "ODOT" SET IN THE TOP OF CURB ON STANBURY ST. BEARS N. 64° 08' 48" E., 28.90'.

A 1" DIA. X 1.5" BRASS DISK, MARKED "ODOT" SET IN THE TOP OF CURB ON STANBURY ST. BEARS S. 33° 07' 30" W., 14.99'.

THE BEARINGS SHOWN ARE BASED UPON A THE USE OF A LEICA TCRP 1201

WITNESS:

BRENT REYNOLDS, BRENT MERRIMAN,
TONY BASHAW, & TRAVIS COEFFELT

I HEREBY CERTIFY THAT THE ABOVE CORNER POSITION WAS REESTABLISHED AS HEREON DESCRIBED IN OCTOBER, 2011

RECEIVED BY
Morrow County Surveyor

Date: 5-20-2013

Rec'd By: S.K.H

No.: 25-26 V18

Folder No.: _____

REGISTERED
PROFESSIONAL
LAND SURVEYOR

OREGON
JULY 25, 1995
ROBERT E. BUTLER
2733

RENEWS: 12/31/2013

OREGON DEPARTMENT OF TRANSPORTATION

**RIGHT OF WAY
ENGINEERING**

Section	OR74: WILLOW CREEK BRIDGE - MORROW COUNTY FAIRGROUNDS (HEPPNER) SECTION		
Highway	HEPPNER HIGHWAY NO. 52 (OR 74)		
County	MORROW	Scale	NOT TO SCALE
Purpose	ORS 209.150 FINAL PLAT		
Date	MARCH, 2013		