


CERTIFIED RECORD OF LAND CORNER MONUMENTATION

1-18

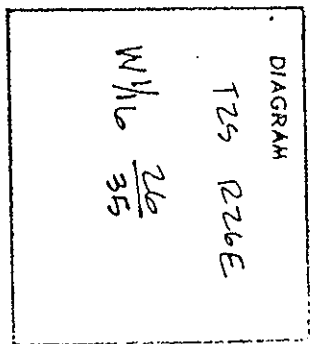



History of original corner establishment:

Description of corner evidence found:

I found a 2 inch in diameter pipe as recorded with a 5/8 inch iron pin in center of pipe.

Description of monument and accessories established to perpetuate the original location of this corner

I set a 2 1/2 inch in diameter brass cap on a 2 1/2 inch diameter iron pipe 30 inches long.  
Cap is 6 inches below street grade.

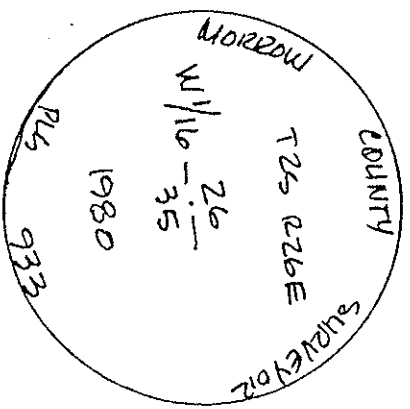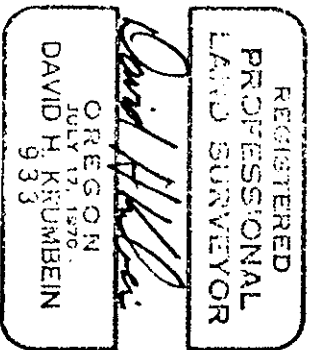

Office of ..... County of .....  
State of ..... , I hereby certify that the within instrument was filed in this office  
for record on the ..... day of .....  
(COUNTY OFFICIAL) ..... by ..... (DEPUTY)

RECEIVED BY

Morrow County Surveyor

Date 4-25-80

Rec'd By WMA

No. #289-K

*Cooperating  
drawing*