


CERTIFIED RECORD OF LAND CORNER MONUMENTATION

1-20

History of original corner establishment:

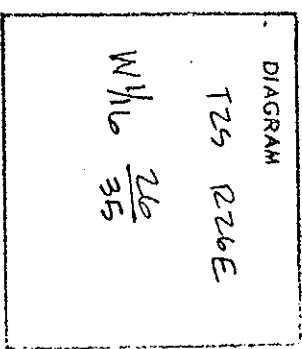



Description of corner evidence found:

I found a 2 inch in diameter pipe as recorded with a 5/8 inch iron pin in center of pipe.

Description of monument and accessories established to perpetuate the original location of this corner

I set a 2 1/2 inch in diameter brass cap on a 2 1/2 inch diameter iron pipe 30 inches long.
Cap is 6 inches below street grade.

LAP STAMPED

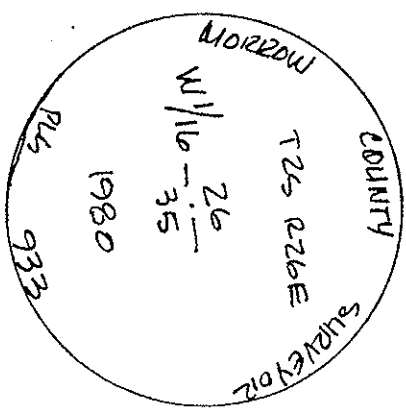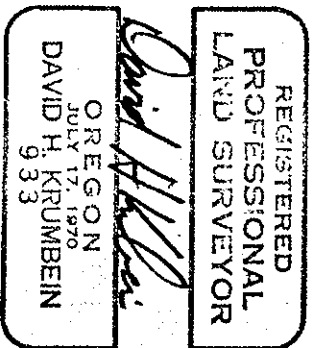

Office of..... County of.....
State of....., I hereby certify that the within instrument was filed in this office
for record on the day of
(COUNTY OFFICIAL) by (DEPUTY)

RECEIVED BY

Morrow County Surveyor
Date 4-25-80
Rec'd By SMAT
No. # 289-K

conspicuously showing