


CERTIFIED RECORD OF LAND CORNER MONUMENTATION

V-21

History of original corner establishment:


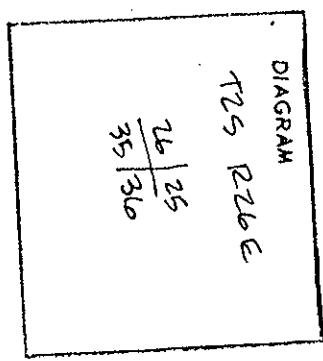


Description of corner evidence found:

I found a 2 inch diameter pipe with 5/8 inch carriage bolt.

Description of monument and accessories I established to perpetuate the original location of this corner

I set a 2 1/2 inch diameter brass cap on a 2 1/2 inch diameter pipe 30 inches long. I set the pipe 24 inches in the ground.

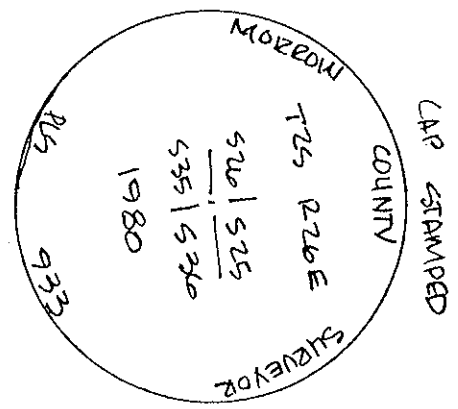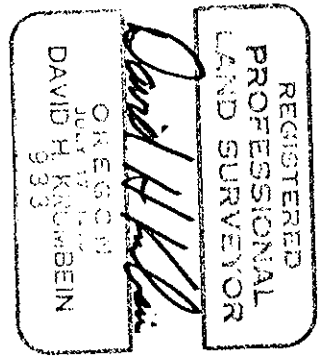

Office of County of
State of I hereby certify that the within instrument was filed in this office
for record on the day of
..... by
(COUNTY OFFICIAL) (DEPUTY)

RECEIVED BY
Morrow County Surveyor
Date 4-25-80
Rec'd By MSJ
No. # 289-K