

OREGON CORNER RESTORATION FORM

Section 8 Township 2S Range 27E
 County Morrow Date: September 20, 2018

Corner Designation: 2S27E9

Corner to sections 4, 5, 8, and 9, T2S, R27E,
 W.M., Morrow County, Oregon.

Condition Report Only
 Not found
 Remonumented
 Unrecorded
 Surveyed in
 Referenced out


Previous Renewals / Surveys, etc.

Corner originally set by David P. Thompson under contract No. 122 dated June 13, 1867. His record reads: Set a stone 16x10x8 inches as corner to sections 4, 5, 8 & 9. In 1914 Loy Turner in survey 1130A found a stone he said "tallied with the field notes as the original stone" in a pile of rocks in the fence corner. Mr. Turner held this point to proportion the 1/4 corner to the north.


Monument and Accessories found: (condition and source)

A three way fence corner with a gate in each direction creating 4 rock jacks within a circle of about 20 feet radius. I searched the 4 rock jacks and did not find a marked stone.

DIAGRAM

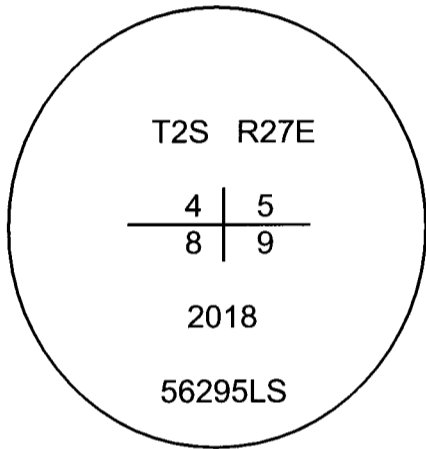

SKETCH

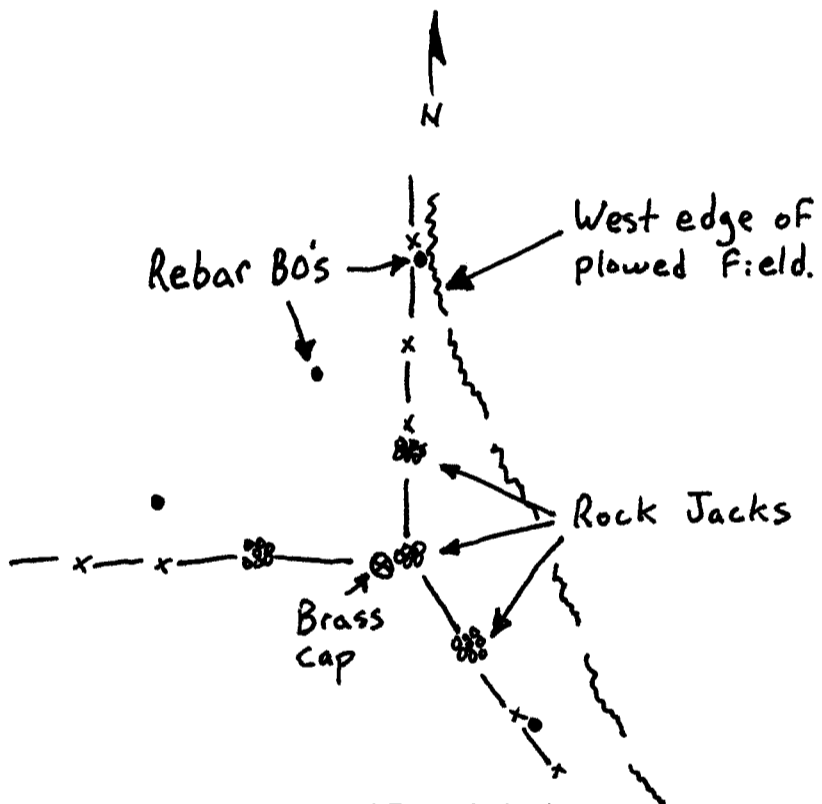

MONUMENT (S) AND ACCESSORIES SET (Procedures and Description)

I held the fence corner reported by County Surveyor Loy Turner.

For references, I set four 5/8" by 24" rebars with 1 1/8" orange plastic caps stamped WTS and 56295LS as follows:

- an iron rebar bears N77°33'22"W, 48.46 feet, flush with the surface in a small mound of earth;
- an iron rebar bears N10°26'11"W, 75.49 feet, flush with the surface in a small mound of earth;
- an iron rebar bears N00°57'34"E, 175.24 feet, flush with the surface in the edge of a plow berm;
- an iron rebar bears S38°13'52"E, 65.30 feet, flush with the surface under the existing fence;

The monument and references were tied using a Trimble R7/R8 RTK GPS.

Location and comments

Compass Declination

Surveyors Seal

RECEIVED BY:

Morrow County Surveyor

Date: 9-30-2018

Rec'd By: S.K.H.

No. 2S27E9

Firm / Agency

Witness Tree Surveying

Address

P.O. Box G

Pilot Rock, Or. 97868