


CERTIFIED RECORD OF LAND CORNER MONUMENTATION

N - 17
DIAGRAM

History of original corner establishment:

The original corner was established by George S. Pershin on September 14, 1871, under GLO contract No. 154, as follows:

Set a stone, 30" x 8" x 5", on southwest hillside for corner to sections 14, 15, 22 and 23.

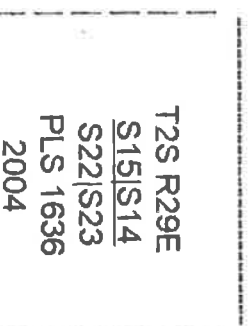

Original corner evidence recovered:

Found the original corner stone loosely set on the east edge of a mound of stones. The original corner stone is 28" x 8" x 5" and is plainly marked with three notches on one (south) edge and two notches on another (east) edge.

Monument and accessories established to perpetuate the original position of this corner:

In place of the corner stone, I set a 1" x 18" flared, galvanized iron pipe 16" into the ground to bedrock. I place a non-functioning pocket watch at the base of the monument as a memorial and bury the corner stone along the northeast side of the pipe and build a mound of stones around the pipe. A 2 1/2" brass cap attached to the top of the pipe is marked as shown in the diagram above, from which:

A 5/8" x 24" iron rod set 23" into the ground with a 3/4" brass washer, marked "PLS 1636 14", attached at ground level, bears N31° E, 94.6 feet.

A 5/8" x 24" iron rod set 23" into the ground with a 3/4" brass washer, marked "PLS 1636 23", attached at ground level, bears S58° E, 152.6 feet.

The above two references are about 10 to 20 feet west of small earth dams constructed to capture spring water in ponds.

A 5/8" x 24" iron rod set 23" into the ground with a 3/4" brass washer, marked "PLS 1636 22", attached at ground level, bears S30° 30' W, 94.1 feet.

A 5/8" x 24" iron rod set 23" into the ground with a 3/4" brass washer, marked "PLS 1636 15", attached at ground level, bears N41° 30' W, 108.9 feet.

I hereby certify the above corner point was perpetuated as hereon described on March 25, 2004. Magnetic declination set in compass: 18° E.
NAD '83 UTM Zone 11 position: 5028130N, 328751E (plus or minus two meters).

RECEIVED BY
Morrow County Surveyor

Dennis L. Gaylor



Date: 1-4-14
Recd By: S.K.H.
No.: 2529 K17
Folder No.: _____

Renews June 30, 2005

Recorded at the office of County Surveyor, County of Morrow, State of Oregon, on: