


CERTIFIED RECORD OF LAND CORNER MONUMENTATION

P - 17
DIAGRAM

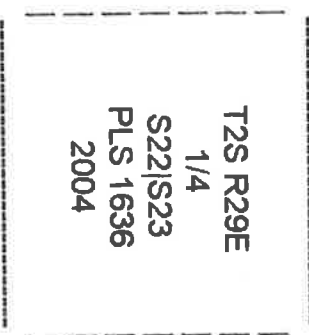

History of original corner establishment:

The original corner was established by George S. Pershin on September 14, 1871, under GLO contract No. 154, as follows:

Set a stone, 20" x 8" x 5", on northeast hillside for the 1/4 section corner to sections 22 and 23.

Original corner evidence recovered:

Found the original corner stone solidly set 1 1" into the ground. The corner stone is 20" x 8" x 6" and is plainly marked "1/4" on the east face.

Monument and accessories established to perpetuate the original position of this corner:

In place of the original corner stone, I set a 1" x 30" flared, galvanized iron pipe 27" into the ground. A 2 1/2" brass cap attached to the top of the pipe is marked as shown in the diagram above. I bury the corner stone along the west side of the pipe and build a small mound of stones around the pipe, from which:

- A 5/8" x 24" iron rod set 23" into the ground, with a 3/4" brass washer, marked "PLS 1636 NE", attached at ground level, bears N32° E, 92.3 feet.
- A 5/8" x 24" iron rod set 23" into the ground, with a 3/4" brass washer, marked "PLS 1636 SE", attached at ground level, bears S47° 30' E, 123.5 feet.
- A 5/8" x 24" iron rod set 23" into the ground, with a 3/4" brass washer, marked "PLS 1636 SW", attached at ground level, bears S54° W, 94.9 feet.
- A 5/8" x 24" iron rod set 23" into the ground, with a 3/4" brass washer, marked "PLS 1636 NW", attached at ground level, bears N54° W, 124.3 feet.

I hereby certify the above corner point was perpetuated as hereon described on March 25, 2004. Magnetic declination set in compass: 18° E.
NAD '83 UTM Zone 11 position: 5027326N, 328726E (plus or minus two meters).

RECEIVED BY
Morrow County Surveyor

Dennis L. Gaylord



Date: 1-4-14
Rec'd By: S. K. H.
No.: 2529P17
Folder No.:

Renews June 30, 2005

Recorded at the office of County Surveyor, County of Morrow, State of Oregon, on: