


CERTIFIED RECORD OF LAND CORNER MONUMENTATION

V - 17
DIAGRAM

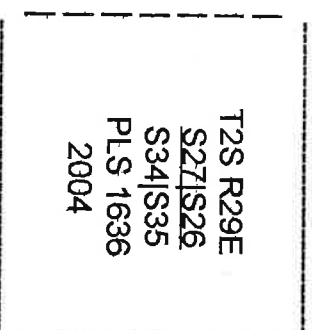

History of original corner establishment:

The original corner was established by George S. Pershin on September 14, 1871, under GLO contract No. 154, as follows:

Set a stone, 18" x 10" x 8", on north hillside at head of ravine for corner to sections 26, 27, 34 and 35.

Original corner evidence recovered:

Found the original corner stone solidly set protruding 6" above the ground surface. The original corner stone is 23" x 12" x 8" and is plainly marked with five notches on the north edge and two notches on the east edge. Upon excavating to set the pipe monument, I find a 3" x 3" partly decayed wood post with a sharpened and charred tip set 20" into the ground alongside the south side of the corner stone.

Monument and accessories established to perpetuate the original position of this corner:

In place of the corner stone, I set a 1" x 30" flared, galvanized iron pipe 28" into the ground. I bury the original corner stone and wood post fragments along the north side of the pipe. A 2 1/2" brass cap attached to the top of the pipe is marked as shown in the diagram above, from which:

- A 5/8" x 24" iron rod set 23" into the ground with a 3/4" brass washer, marked "PLS 1636 26", attached at ground level, bears N67° E, 123.1 feet.
- A 5/8" x 24" iron rod set 23" into the ground with a 3/4" brass washer, marked "PLS 1636 35", attached at ground level, bears S65° E, 99.0 feet.
- A 5/8" x 24" iron rod set 23" into the ground with a 3/4" brass washer, marked "PLS 1636 34", attached at ground level, bears S67° W, 90.3 feet.
- A 5/8" x 24" iron rod set 23" into the ground with a 3/4" brass washer, marked "PLS 1636 27", attached at ground level, bears N59° W, 57.8 feet.

I hereby certify the above corner point was perpetuated as hereon described on June 21, 2004. Magnetic declination set in compass: 16° E.
NAD 83 UTM Zone 11 position: 5024907N, 328671E (plus or minus two meters).

REGISTERED
PROFESSIONAL
LAND SURVEYOR
OREGON
DENNIS L. GAYLORD
1636

Renews June 30, 2005

Recorded at the office of County Surveyor, County of Morrow, State of Oregon, on:

RECEIVED BY

Morrow County Surveyor

Date: 1-4-2014
Rec'd By: S.K.H.
No.: 2529V17
Folder No.: _____