

OREGON CORNER RESTORATION FORM

Section 1 Township 3N Range 23E Index A-25
 County ~~Umatilla~~ ^{Morrow} Date 5/16/95

CORNER DESIGNATION

NE
 Condition Report Only
 Not Found
 Renewed
 Unrecorded
 Surveyed
 Reference

Previous Renewals/Surveys, etc. _____ Original survey by Thompson in 1867.
 Dependant resurvey by Gould in 1938 and 1939 under GLO letter "E" in 1699812.

Monument(s) & Accessories Found: (Condition and Source)
 Found 3" iron pipe with 3 1/2" standard GLO brass cap stamped as shown below. The monument was buried with 30" of blown sand but was still in the original location.

Monument Detail	Sketch
T4N	
R23E R24E	
S36 S31	
S6 S1	
T3N	
1939	



Monument Set (Procedures and Description)
 Raised monument in original position with top 12" exposed. Placed 3' collar of stone around monument.

New Accessories

- Brass washer stamped ORLS 852 and WALs 13922 attached to 4" steel H
- Brace which bears N88°33'W, 50.40'
- Brass washer stamped ORLS 852 and WALs 13922 attached to 4" steel H
- Brace which bears S14°35'W, 282.12'
- Brass washer stamped ORLS 852 and WALs 13922 attached to 4" steel H
- Brace which bears S44°34'W, 399.81'
- 5.8" rebar with 2" Al cap stamped ORLS 852 and WALs 13922 bears N0°00'E, 52.25'
- 5.8" rebar with 2" Al cap stamped ORLS 852 and WALs 13922 bears S86°05'E, 48.65'

Location & Comments
 From Taggares Farm HQ
 on Three Mile Canyon Road,
 go east and north 3.5
 miles following a power
 line. The corner is 0.1
 mile past the end of the
 power line.

Compass Declination 20°
 Firm/Agency
 Haddock Surveying
 Address P. Box 1574
 Pendleton, OR 97801
 Party Chief D. Haddock
 Notes
 Witness S. Haddock

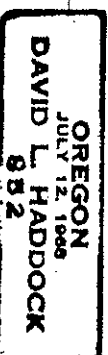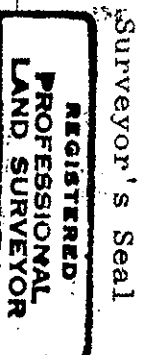

RECEIVED BY

Morrow County Surveyor

Date 6/95
 I add by DE
 No.