

OREGON CORNER RESTORATION FORM

Section 6 Township 3N Range 23E Index C-1  
 County ~~Morrow~~ Morrow Date 4/27/95

CORNER DESIGNATION

West 1/4  
 Condition Report Only  
 Not Found  
 Renewed  
 Unrecorded  
 Surveyed  
 Reference

Previous Renewals/Surveys, etc. Original survey by Thompson in 1867.  
 Dependant resurvey by Gould in 1938 and 1939 under GLO letter "E" 1699812.

Monument(s) & Accessories Found: (Condition and Source)  
 Found 1" iron pipe with 2 1/2" standard GLO brass cap stamped as shown below. Pipe surrounded by 2' stone mound.

Monument Detail


Sketch  
 1/4  
 S1 | S6  
 1939

Monument Set (Procedures and Description)

New Accessories

Brass washer stamped ORLS 852 and WALS 13922 attached to PGE pole A3221 bears N84°48'W, 164.89'.  
 Brass washer stamped ORLS 852 and WALS 13922 attached to 3' concrete manhole bears S17°54'W, 117.55'.  
 5/8" x 24" rebar with 2" Al cap stamped ORLS 852 and WALS 13922 bears N68°10'E, 63.96' in center of abandoned roadway.  
 5/8" x 24" rebar with 2" Al cap stamped ORLS 852 and WALS 13922 bears S61°15'E, 64.61' in center of abandoned roadway.  
 Location & Comments  
 Surveyor's Seal

From Taggares Farm HQ Compass Declination 20°  
 on Three Mile Canyon Road, Firm/Agency  
 go west 2.5 miles to a Haddock Surveying  
 a pumping station. Then go Address P. Box 1574  
 northwest 1.2 miles to a Pendleton, OR 97801  
 BPA substation. Then go Party Chief D. Haddock  
 north 0.5 mile. The corner Notes  
 is west of the road 300'. Witness S. Haddock

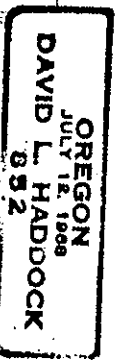

RECEIVED BY

Morrow County Surveyor

Date 4/27/95

Signature DOE

File No. \_\_\_\_\_