

OREGON CORNER RESTORATION FORM

Section 7 Township 3N Range 23E Index F-1
County MORROW Date 5/16/95

CORNER DESIGNATION West 1/4 Condition Report Only
 Not Found
 Renewed
 Unrecorded
 Surveyed
 Reference

Previous Renewals/Surveys, etc. Original survey by Thompson in 1867.
Dependant resurvey by Gould in 1938 and 1939 under GLO letter "E"
1699812.

Monument(s) & Accessories Found: (Condition and Source)
Found 1" iron pipe with 2 1/2" standard GLO brass cap stamped as shown
below. Pipe surrounded by 2' stone mound.



Monument Detail Sketch
1/4
S12 | S7
1939

Monument Set (Procedures and Description)

New Accessories
5/8" x 24" rebar with 2" Al cap stamped ORLS 852 and WALs 13922 set in
top of cut bank of primitive road bears N0°00'E, 174.28'.
Center of 11" Juniper with brass washer stamped ORLS 852 and WALs 13922
nailed to face bears N89°47'E, 191.26'.
5/8" x 24" rebar with 2" Al cap stamped ORLS 852 and WALs 13922
bears N89°34'W, 51.18'. Dead rattler nearby.
5/8" x 24" rebar with 2" Al cap stamped ORLS 852 and WALs 13922
bears S0°29'E, 44.32'.
Location & Comments

Surveyor's Seal

From Taggares Farm HQ Compass Declination 20°
on Three Mile Canyon Road, Firm/Agency
go west 2.5 miles to a Haddock Surveying
a pumping station. Then go Address P. Box 1574
northwest crossing a small Pendleton, OR 97801
draw and then take the Party Chief D. Haddock
second road to the right. Notes
Follow the road 0.5 mile into a draw. The corner is
160' south of the road. Witness S. Haddock

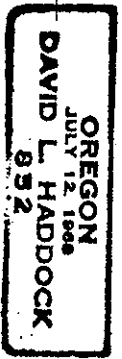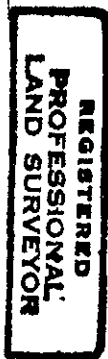

RECEIVED BY

Morrow County Surveyor

Date 5-16-95
DE