

OREGON CORNER RESTORATION FORM

Section 34 Township 3N Range 23E Index 2-13

County MORROW Date 5/03/95

CORNER DESIGNATION _____ Condition Report Only

SW _____
 _____ Not Found
 _____ x Renewed
 _____ Unrecorded
 _____ Surveyed
 _____ Reference

Previous Renewals/Surveys, etc. _____ Original survey by Thompson in 1867.
 Dependant resurvey by Gould in 1938 and 1939 under GLO letter "E"
 1699812.

Monument(s) & Accessories Found: (Condition and Source)
 Found 1" iron pipe with 2 1/2 " standard GLO brass cap stamped as shown below.

Monument Detail	Sketch
T3N R23E	
S33 S34	
----- -----	
S4 S3	
T2N	
1939	

Monument Set (Procedures and Description)



New Accessories

Brass washer stamped ORLS 852 and WALIS 13922 attached to the leg of transmission tower mile 7, tower 4 bears S49°59'E, 319.88'.
 5.8" rebar with 2" AI cap stamped ORLS 852 and WALIS 13922 bears N0°00'E, 33.33'.
 5.8" rebar with 2" AI cap stamped ORLS 852 and WALIS 13922 bears N87°31'W, 50.66'.
 5.8" rebar with 2" AI cap stamped ORLS 852 and WALIS 13922 bears S85°38'E, 49.80'.

Location & Comments

From Taggares Farm HQ Compass Declination 20°
 on Three Mile Canyon Road, Firm/Agency
 go south 4.5 miles to the Haddock Surveying
 powerline service road. Address P. Box 1574
 Go east to tower mile 4, Pendleton, OR 97801
 tower 4. Then go back west Party Chief D. Haddock
 3.0 mile. Notes _____
 Witness S. Haddock

Surveyor's Seal

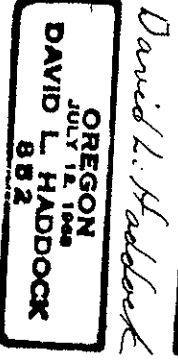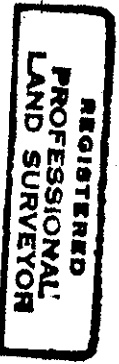

RECEIVED BY

Morrow County Surveyor

Date 6/25
 by DOE