

OREGON CORNER RESTORATION FORM

Section 34 Township 3N Range 23E Index 2-15
County ~~Morrow~~ Morrow Date 5/03/95

CORNER DESIGNATION

S 1/4

Condition Report Only
 Not Found
 Renewed
 Unrecorded
 Surveyed
 Reference

Previous Renewals/Surveys, etc. Original survey by Thompson in 1867. Dependant resurvey by Gould in 1938 and 1939 under GLO letter "E" 1699812.

Monument(s) & Accessories Found: (Condition and Source)
Found 1" iron pipe with 2 1/2 " standard GLO brass cap stamped as shown below.

Monument Detail Sketch

S34
1/4-----
S3
1939

Monument Set (Procedures and Description)

New Accessories


Brass washer stamped ORLS 852 and WALIS 13922 attached to the leg of transmission tower mile 7, tower 1 bears S40°09'E, 184.58'.
5.8" rebar with 2" A1 cap stamped ORLS 852 and WALIS 13922 bears N0°00'E, 45.43'.
5.8" rebar with 2" A1 cap stamped ORLS 852 and WALIS 13922 bears N88°48'W, 51.32'.
Center of 17" Juniper with brass washer stamped ORLS 852 and WALIS 13922 bears N78°30'E, 322.21'.

Location & Comments
From Taggares Farm HQ
on Three Mile Canyon Road,
go south 4.5 miles to the
powerline service road.
Go east to tower mile 4,
tower 4. Then go back west
1.5 mile.

Compass Declination 20°
Firm/Agency
Haddock Surveying
Address P. Box 1574
Pendleton, OR 97801
Party Chief D. Haddock

Notes
Witness S. Haddock

Surveyor's Seal

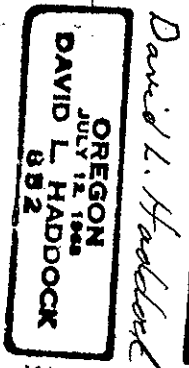

RECEIVED BY

Morrow County Surveyor

Date 6/95
DE