

OREGON CORNER RESTORATION FORM

Section 36 Township 3N Range 23E Index Z-23


CORNER DESIGNATION

S 1/4

Condition Report Only

Not Found
 Renewed
 Unrecorded
 Surveyed
 Reference

Previous Renewals/Surveys, etc. _____ Original survey by Thompson in 1867.
 Dependant resurvey by Gould in 1938 and 1939 under GLO letter "E"
 1699812.

Monument(s) & Accessories Found: _____ (Condition and Source)
 Found 1" iron pipe with 2 1/2" standard GLO brass cap stamped as shown
 below.

Monument Detail

Sketch

S36
 1/4-----
 S1
 1939

Monument Set (Procedures and Description)



New Accessories

Brass washer stamped ORLS 852 and WALIS 13922 attached to the leg of
 transmission tower bears S70°26'E, 372.61'.
 5.8" rebar with 2" A1 cap stamped ORLS 852 and WALIS 13922 bears
 N0°00'E, 30.00'.
 5.8" rebar with 2" A1 cap stamped ORLS 852 and WALIS 13922 bears
 N87°01'W, 30.00'.
 5.8" rebar with 2" A1 cap stamped ORLS 852 and WALIS 13922 bears
 N86°52'E, 30.00'.
 5.8" rebar with 2" A1 cap stamped ORLS 852 and WALIS 13922 bears
 S0°20'W, 30.00'.

Surveyor's Seal

Location & Comments
 From Taggares Farm HQ
 on Three Mile Canyon Road,
 go south 4.5 miles to the
 powerline service road.
 Go east to tower mile 4,
 tower 4. Then go back west
 0.5 mile.

Compass Declination 20°
 Firm/Agency
 Haddock Surveying
 Address P. Box 1574
 Pendleton, OR 97801
 Party Chief D. Haddock
 Notes
 Witness S. Haddock

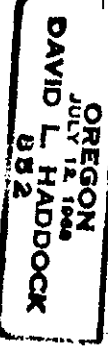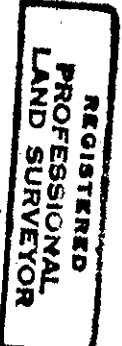

RECEIVED BY

Morrow County Surveyor

Date 6/1/95

Received by DE

by _____