

OREGON CORNER RESTORATION FORM

Section 36 Township 3N Range 23E Index Z-25
 County ~~Umatilla~~ ^{Morrow} Date 5/03/95

CORNER DESIGNATION _____
 SE _____
 Condition Report Only
 _____ Not Found
 _____ x Renewed
 _____ Unrecorded
 _____ Surveyed
 _____ Reference

Previous Renewals/Surveys, etc. _____ Original survey by Thompson in 1867.
 Dependant resurvey by Gould in 1938 and 1939 under GLO letter "E"
 1699812.

Monument(s) & Accessories Found: (Condition and Source)
 Found 3" iron pipe with 3 1/2" standard GLO brass cap stamped as shown
 below. A 2' stone mound surrounds the corner.

Monument Detail	Sketch
T3N	
S36 S31	
----- -----	
S1 S6	
R23E R24E	
T2N	
1939	


Monument Set (Procedures and Description)

New Accessories
 Brass tag on leg of power line mile 4 tower 4 bears S46°43'W, 104.30'.
 Brass tag on leg of power line mile 4 tower 4 bears S54°28'W, 119.17'.
 5/8" x 24" rebar with 2" AI cap stamped ORLS 852 and WALIS 13922
 bears N84°47'W, 30.00'.
 5/8" x 24" rebar with 2" AI cap stamped ORLS 852 and WALIS 13922
 bears S84°46'E, 30.00'.
 5/8" x 24" rebar with 2" AI cap stamped ORLS 852 and WALIS 13922
 bears NO°00'E, 30.00'

Location & Comments
 From Taggares Farm HQ
 on Three Mile Canyon Road, Firm/Agency
 go south 4.5 miles to the Haddock Surveying
 power line service road. Address P. Box 1574
 Go east on this road to Pendleton, OR 97801
 mile 4, tower 4. Party Chief D. Haddock

Notes _____
 Witness S. Haddock

Surveyor's Seal

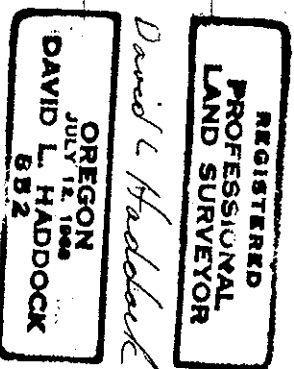

David L. Haddock

RECEIVED BY

Morrow County Surveyor

Date 6/95

Rec'd by DE

No. _____