

OREGON CORNER RESTORATION FORM

Section 10 Township 3 N. Range 24 E.

County Morrow Date 3/25/86

Corner Designation


J-15  
Corner Section 10  
15

Previous Renewals/Surveys, etc. \_\_\_\_\_

Condition Report Only  
 Not Found  
 Renewed  
 Unrecorded  
 Surveyed In  
 Referenced Out

Monument(s) & Accessories Found: (Condition and Source)  
Found General Land Office Brass Cap on one (1) inch pipe, firmly set six (6) inches above ground, dated 1939.  
Corner destroyed during construction of Radar Test Range

Monument Detail 3" ALUMINUM CAP MONUMENT (TYP) Sketch

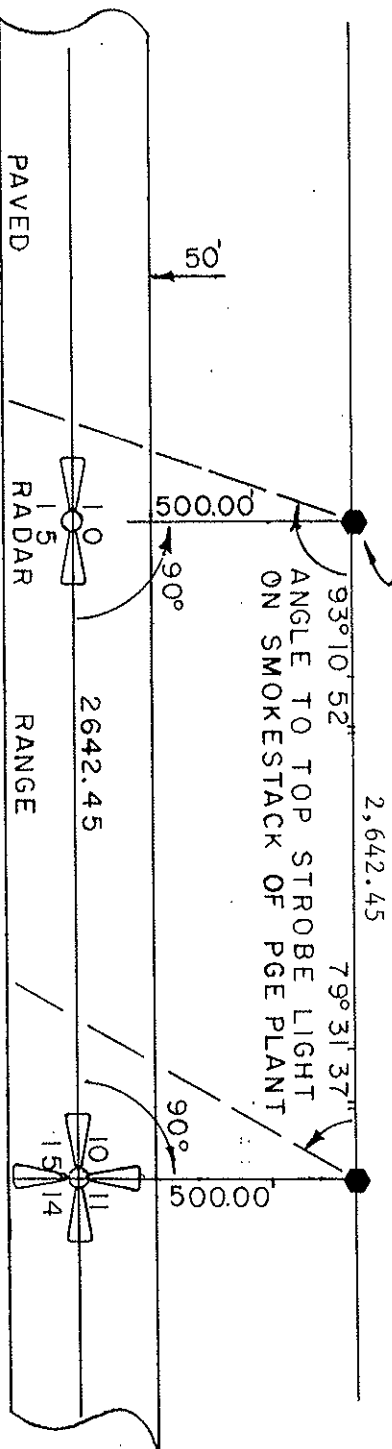

Monument Set (Procedures and Description)

Witness corners required due to major paving/grading project for Boeing Company Radar Range Testing Facility. Restoration of corners at original positions not practical due to facility operations and security.

New Accessories

Three (3) inch Aluminum Cap Monument, thirty (30) inches long, set twenty-four (24) inches in ground stamped: Horton Dennis & Assoc., Seattle, WA Ref. Mon. 10/15 Township 3 N., Range 24 E. 500.00 South 1986

Monuments are "Berntsen" Model No. A-1-SB, split base, BIM approved for cadastral use.

Location & Comments

Access to the new witness monuments will require clearance from Boeing Facilities Manager at Boardman Office or call (206) 763-5650, Boeing Co., Seattle, WA

Compass Declination N/A

Firm/Agency Horton Dennis & Associates, Inc.


Address Fuller-Quigg Bldg. Wenatchee, WA 98801

Party Chief Richard Moody

Notes BAC #W623.0

Witness N/A

Surveyor's Seal

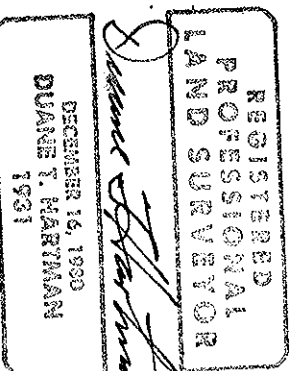

RECEIVED BY

Morrow County Surveyor  
Date 4/6/86

Rec'd by DJED  
No. 809-K