

# OREGON CORNER RESTORATION FORM

SECTION 33  
4

TOWNSHIP 4 NORTH  
3 NORTH

RANGE 26 EAST

COUNTY: MORROW

DATE: 03/01/2016

CORNER DESIGNATION: A-11


## PREVIOUS RENEWALS / SURVEYS, etc.

THE ORIGINAL CORNER SET BY U.S. DEPUTY SURVEYOR E.E.HAFT IN 1861. HE SET A POST IN MOUND WITH TRENCH AND PITS AND DEPOSITED A PINT OF CHARCOAL. OTIS GOULD CONDUCTED A DEPENDENT RESURVEY COMPLETED IN 1941. AT THAT TIME HE SET A 2" DIAMETER 3' LONG IRON POST WITH A BRASS CAP AND DUG PITS.

## MONUMENT and ACCESSORIES FOUND: ( CONDITION AND SOURCE )

NO EVIDENCE OF THE ORIGINAL OR LATER SET MONUMENTS WAS FOUND. THE NORTHWEST CORNER OF SECTION 4 WAS FOUND. IT IS A GLO BRASS CAP PER THE 1941 RESURVEY. THE NORTHEAST CORNER WAS ALSO FOUND. IT IS A 2" CONCRETE FILLED PIPE AT THE SAME POSITION AS PARTITION PLAT 2006-5 SHOWS A FOUND GLO BRASS CAP. THIS WAS CONFIRMED BY MEASUREMENT TO THE NORTHEAST CORNER OF SECTION 3. THE QUARTER CORNER WAS THEN SET BY MODIFIED SINGLE PROPTION PER SECTION 7-52 OF THE 2009 BLM MANUAL BETWEEN THE TWO FOUND SECTION CORNERS PER THE 1941 GLO DEPENDANT RESURVEY.

DIAGRAM:

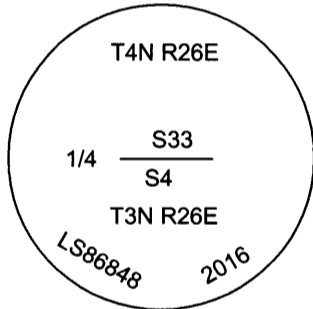

## MONUMENT and ACCESSORIES SET ( PROCEDURES and DESCRIPTION )

SET A 2-1/2" BRASS CAP ON A 1" I.D. 30" LONG FLARED PIPE. MARKED AS SHOWN.

## REFERENCES SET:

From a tee post the corner bears S0°00'E 26.1'  
From a power pole the corner bears N13°43'W 31.5'  
From a tee post the corner bears N13°43'W 9.7' (in line with the pp)  
From the west face of a 4"X6" fence post the corner bears N83°39'W 80.7'  
(Bearings are Grid)

## LOCATION and COMMENTS

NAD83 / 2011 Oregon North coordinates (International Feet)  
N 770924.70  
E 8439321.70

## SURVEYORS SEAL

REGISTERED  
PROFESSIONAL LAND  
SURVEYOR

*Shall*

OREGON  
NOVEMBER 13, 2012  
DAVID P. BAALMAN  
86848PLS

RENEWS: 12/31/2017

5-12-16

## RECEIVED BY:

MORROW COUNTY SURVEYOR

DATE 5-17-2016

REC'D BY: S.K.H.

NO. 3N26A11

## FIRM / AGENCY

ROGERS SURVEYING, Inc., P.S.  
1455 COLUMBIA PARK TRAIL, #201  
RICHLAND, WA 99352  
(509) 783-4141