

OREGON CORNER RESTORATION FORM

SECTION 32
5

TOWNSHIP 4 NORTH
3 NORTH

RANGE 26 EAST

COUNTY: MORROW

DATE: 04/14/2016

CORNER DESIGNATION: A-7


PREVIOUS RENEWALS / SURVEYS, etc.

THE ORIGINAL CORNER SET BY U.S. DEPUTY SURVEYOR E.E.HAFT IN 1861. HE SET A POST IN MOUND WITH TRENCH AND PITS AND DEPOSITED A PINT OF CHARCOAL. OTIS GOULD CONDUCTED A DEPENDENT RESURVEY COMPLETED IN 1941. AT THAT TIME HE SET A 2" DIAMETER 3' LONG IRON POST WITH A BRASS CAP AND DUG PITS. IN 2004 RONALD MCKINNIS (LS 2431) WAS NOT ABLE TO FIND THE PREVIOUS CORNERS AND SET A NEW 2-1/2" BRASS CAP ON A 1" IRON PIPE APPROXIMATELY 12" BELOW THE GROUND SURFACE AND REFERENCED IT PER HIS RECORD OF LAND CORNER MONUMENTATION RECORDED UNDER SURVEY NUMBER D-1410-M.

MONUMENT and ACCESSORIES FOUND: (CONDITION AND SOURCE)

THE MCKINNIS MONUMENT AS DESCRIBED WAS FOUND ALONG WITH HIS REFERENCES. NEW FARMING OPERATIONS REQUIRED THE REMOVAL OF THE NORTHERLY MCKINNIS REFERENCE SET ON A UTILITY POLE. A NEW REFERENCE WAS THEREFORE ESTABLISHED TO REPLACE THE LOST ONE.

DIAGRAM:

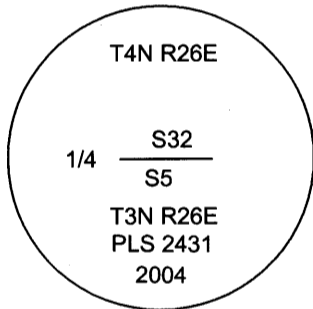

MONUMENT and ACCESSORIES SET (PROCEDURES and DESCRIPTION)

FOUND A 2-1/2" BRASS CAP ON A 1" I.D. 30" LONG FLARED PIPE. MARKED AS SHOWN.

REFERENCES SET:

From the southeast corner of a concrete pad for a center pivot the corner bears S82°W, 77.8' (Bearing is Grid)

REFERENCES FOUND:

From a utility pole the corner bears S68°23'48" E 93.2'
From a utility pole the corner bears N15°30' 19" E 315.5'
From a utility pole the corner bears S84°39'58"E 344.1'
(Bearings are from D-1410-M)

LOCATION and COMMENTS

NAD83 / 2011 Oregon North coordinates (International Feet)
N 770865.72
E 8434125.07

RECEIVED BY:

MORROW COUNTY SURVEYOR

DATE 5-17-2016

REC'D BY: S.K.H.

NO. 3426A7

FIRM / AGENCY

ROGERS SURVEYING, Inc., P.S.
1455 COLUMBIA PARK TRAIL, #201
RICHLAND, WA 99352
(509) 783-4141

SURVEYORS SEAL

REGISTERED
PROFESSIONAL LAND
SURVEYOR

5-17-16 *[Signature]*

OREGON
NOVEMBER 13, 2012
DAVID P. BAALMAN
86848PLS

RENEWS: 12/31/2017