

OREGON CORNER RESTORATION FORM

SECTION 4, 3, 9, 10

TOWNSHIP 3 NORTH

RANGE 26 EAST

COUNTY: MORROW

DATE: 03/01/2016

CORNER DESIGNATION: E-13


PREVIOUS RENEWALS / SURVEYS, etc.

THE ORIGINAL CORNER SET BY U.S. DEPUTY SURVEYOR E.E.HAFT IN 1861. HE SET A CHARRED STAKE & RAISED A MOUND WITH TRENCHES. OTIS GOULD CONDUCTED A DEPENDENT RESURVEY COMPLETED IN 1941. AT THAT TIME HE FOUND THE REMAINS OF AN OLD STAKE WITH INCOMPLETE SCRIBE MARKS, AND SET A 2" DIAMETER 3' LONG IRON POST WITH A BRASS CAP AND DUG PITS. IN THE EARLY 1970'S ROGERS SURVEYING INC. SURVEYED THIS CORNER AS PART OF WORK FOR DEVELOPMENT OF SABRE FARMS (SEE SURVEY 2016-1759C).

MONUMENT and ACCESSORIES FOUND: (CONDITION AND SOURCE)

AT THE CORNER POSITION WE FIND THE 1939 GLO MONUMENT BENT APPROXIMATELY 90°. WE STRAIGHTEN THE MONUMENT AT THE POINT OF DISTURBANCE AND CONFIRM IT IS IN IT'S ORIGINAL POSITION BY COMPARING TO OUR 1973 SURVEY, USING A GRANT BOUNDARY METHOD AGAINST CORNERS TO THE WEST & SOUTH

DIAGRAM:

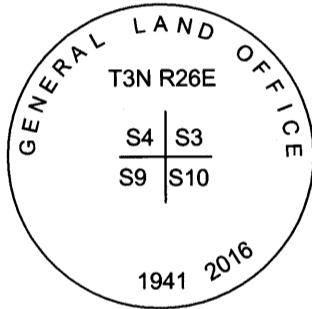

MONUMENT and ACCESSORIES SET (PROCEDURES and DESCRIPTION)

RESTORED THE 1939 GLO BRASS CAP TO IT'S ORIGINAL POSITION

REFERENCES SET:

- From a tee post the corner bears S5°W 0.9'
 - From a 6"x6" fence post the corner bears S87°24'E 22.1'
 - From a power pole the corner bears N88°W 40.5'
 - From a 6"x6" railroad tie fence post the corner bears N23°26'W 85.2'
- (Bearings are Grid)

LOCATION and COMMENTS

NAD83 / 2011 Oregon North coordinates (International Feet)
N 765497.27
E 8441991.85

SURVEYORS SEAL

REGISTERED
PROFESSIONAL LAND
SURVEYOR

OREGON
NOVEMBER 13, 2012
DAVID P. BAALMAN
86848PLS

RENEWS: 12/31/2017

5-17-16

RECEIVED BY:

MORROW COUNTY SURVEYOR

DATE 5-17-2016

REC'D BY: S.K.H.

NO. 3426 E13

FIRM / AGENCY

ROGERS SURVEYING, Inc., P.S.
1455 COLUMBIA PARK TRAIL, #201
RICHLAND, WA 99352
(509) 783-4141