

OREGON CORNER RESTORATION FORM

T2N R27E A1

Section 6, Township 2N, Range 27E,
County Morrow, Date November 15, 2004.

Condition Report
 Not Found
 Remonumented
 Unrecorded
 Surveyed in
 Referenced out


Township corner common to Townships 2 and 3 North
Ranges 26 and 27 East, W.M., Umatilla County, Oregon.

Previous Renewals / Surveys, etc.

The corner was originally set by Ebenezer E. Haft under Contract No. 91 dated September 11, 1860. His record Reads: Set post for corner to Townships 2 & 3 North, Ranges 26 & 27 East in mound with trench & pits and deposit a pint of charcoal as per instructions. The corner was remonumented by Otis Gould under Contract No. 217 dated March 12, 1938. His Record reads: .. the rotten remains of old stake, bearing traces of incomplete scribe marks. At point for cor. Set an iron post, 3 ft. long, 3 ins. diam., 27 ins. in the ground, with the marked stake deposited at the base, for cor. to Tps. 2 and 3 N., Rs. 26 and 27 E., with brass cap.... dig pits 18 x 18 x 12 ins. in each sec., 3 ft. dist..

Monument and accessories found: (Condition and source)

I found a 3 1/2" brass cap on a 3" iron pipe in good condition. The cap protrudes approximately 8" above the surface of the ground. A broken off steel guard post lay on the ground nearby.

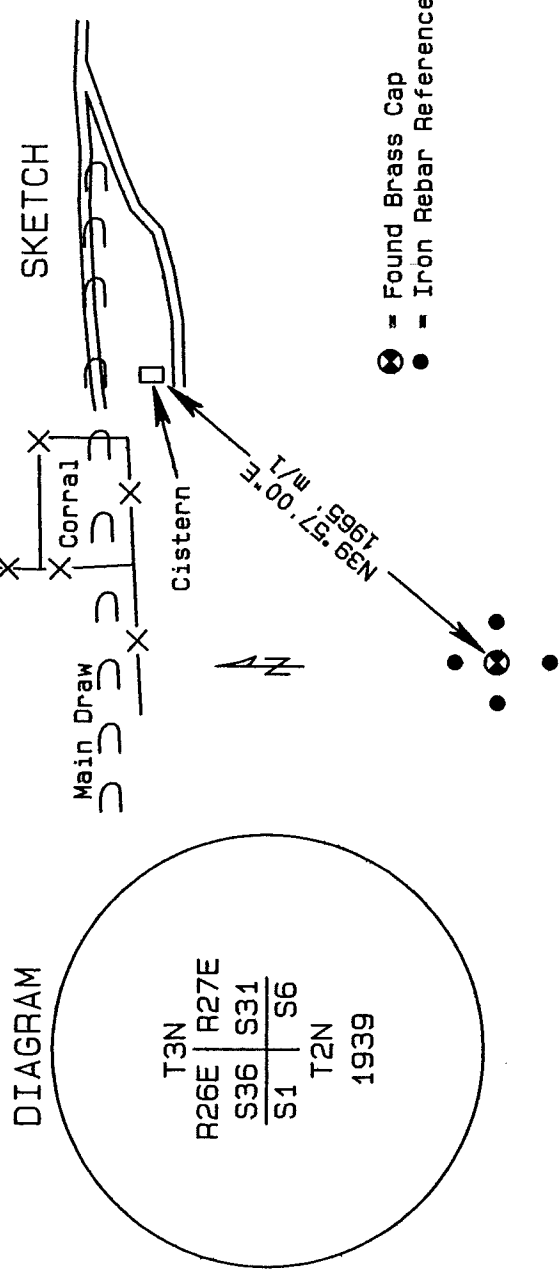

Monument and accessories set: (Procedures and description)

For references I set four 5/8" x 24" iron rebars with 1.25" orange plastic caps stamped WTS and 56295LS approximately 12" below the surface of the ground: an iron rebar bears N0°22'51"E 51.86 feet; an iron rebar bears N89°32'45"E 51.29 feet; an iron rebar bears S0°14'45"E 66.73 feet; an iron rebar bears S89°12'00"W 50.78 feet; The monument and references were tied with a Trimble R7/R8 system using static surveying procedures. Bearings are Grid.

Location and Comments
SPC Oregon North, NAD 83-91
Northing = 739,268.66 ift
Easting = 8,458,131.77 ift

Compass Declination

Surveyor's Seal

Witnessed By:

RECEIVED BY:
Umatilla County Surveyor
Date: 5-05
Rec'd By: KR
No. 05-111-C

Firm / Agency
Witness Tree Surveying
P.O. Box G
Pilot Rock, OR 97868
Party Chief
Stephen K. Haddock, PLS

REGISTERED
PROFESSIONAL
LAND SURVEYOR

Stephen K. Haddock

OREGON
JULY 9, 2001
STEPHEN K. HADDOCK
56295LS

RENEWAL DATE 6-30-05