

OREGON CORNER RESTORATION FORM

COUNTY: Morrow. DATE: 03/28/17.

CORNER DESIGNATION: J-3, The North One-Quarter of Section 18, Township 3 North, Range 27 East, W.M..

PREVIOUS RENEWALS/SURVEYS ETC: Corner originally established by E. E. Haft, under Contract No. 93 dated September 11, 1860. Notes state: Set post q. sec. corner in mound with trench and pits and deposited pint of charcoal as per instructions. Corner was reestablished by proportionate measure by Otis Gould, GLO Surveyor, in May, 1940. Gould's notes state: Set an iron post, 3 ft. long, 1 in. Diam., 27 ins. in the ground for 1/4 sec. cor., with brass cap, dug pits 18x18x12 ins., E. and W. of post, 3 ft. dist. This corner was recovered and tied by survey by Rogers Surveying in 1973, as shown on Survey No. 1759.

MONUMENT AND ACCESSORIES FOUND: None. The corner monument has been removed by farming operations. I reestablish the position of this corner using the compass rule method between the recovered Northeast corner and reestablished Northwest corners of Section 18, using the Rogers Surveying Survey No. 1759 record.

MONUMENT MARKING DETAIL:

T3N R27E
S7
1/4 -----
S18
2017
PLS 1106

MONUMENT SET: Set a 2 3/8" diameter brass cap on a 1 1/4"x30" galvanized iron pipe, 32" in the ground, marked as shown in "Monument Marking Detail".

New accessories:

A 5/8" by 24" rebar with red plastic cap bears N 47°58' E, 106.8'.

A 5/8" by 24" rebar with red plastic cap bears N 00°00' E, 71.4'.

A 5/8" by 24" rebar with red plastic cap bears N 46°23' W, 101.5'

A.5/8" by 24" rebar with red plastic cap bears N 66°27' W, 171.4'. This rebar is 1 ft. East of the SE corner of an electrical vault.

Accessory bearings are Oregon State Plane grid.

The red plastic caps are marked "ORPLS 1106 WAPLS 17372". All rebar accessories have "bearing object" signs wired to them. Wired a "Witness" sign to steel fence post set 8' North of corner monument.

LOCATION AND COMMENTS: Corner is located 100 feet South of a private East-West farm road and 70 feet South of a Umatilla Electric Cooperative power line.

OREGON STATE PLANE COORDINATE, North Zone, NAD83(2011), epoch 2010:

N = 760480.58

E = 8460808.89

FIRM: Wells Surveying

P.O. Box 1696

Pendleton, OR 97801

Surveyor's Seal

RECEIVED BY

Morrow County Surveyor


3N27J3

Date: 4-11-2017


Rec'd By: S.K.H.

No.: 2017-17980C

Folder No.: 3N27J3

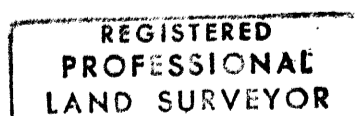

William R. Wells

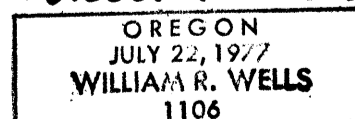

renews 6-30-18