

OREGON CORNER RESTORATION FORM

Section 3 Township 3S Range 24E
County Morrow Date: July 3rd, 2015

Corner Designation: 3S24C9

Condition Report Only
Not found _____
Remonumented x
Unrecorded _____
Surveyed in _____
Referenced out x

Quarter corner common to sections 4 and 5, T3S, R24E, W.M., Morrow County, Oregon.


Previous Renewals / Surveys, etc.

Corner was originally set by David P. Thompson under contract No. 122 dated June 13th, 1867. His record reads: Set 1/4 Sec. corner in mound of earth with charred stake, pits and C as per instructions.


Monument and Accessories found: (condition and source)

None, the position falls in the middle of a road intersection that has been excavated and gravelled.

DIAGRAM

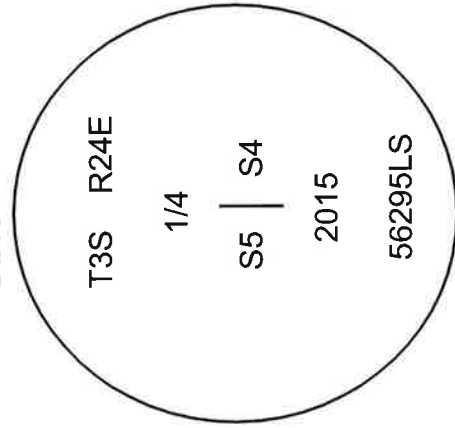

SKETCH

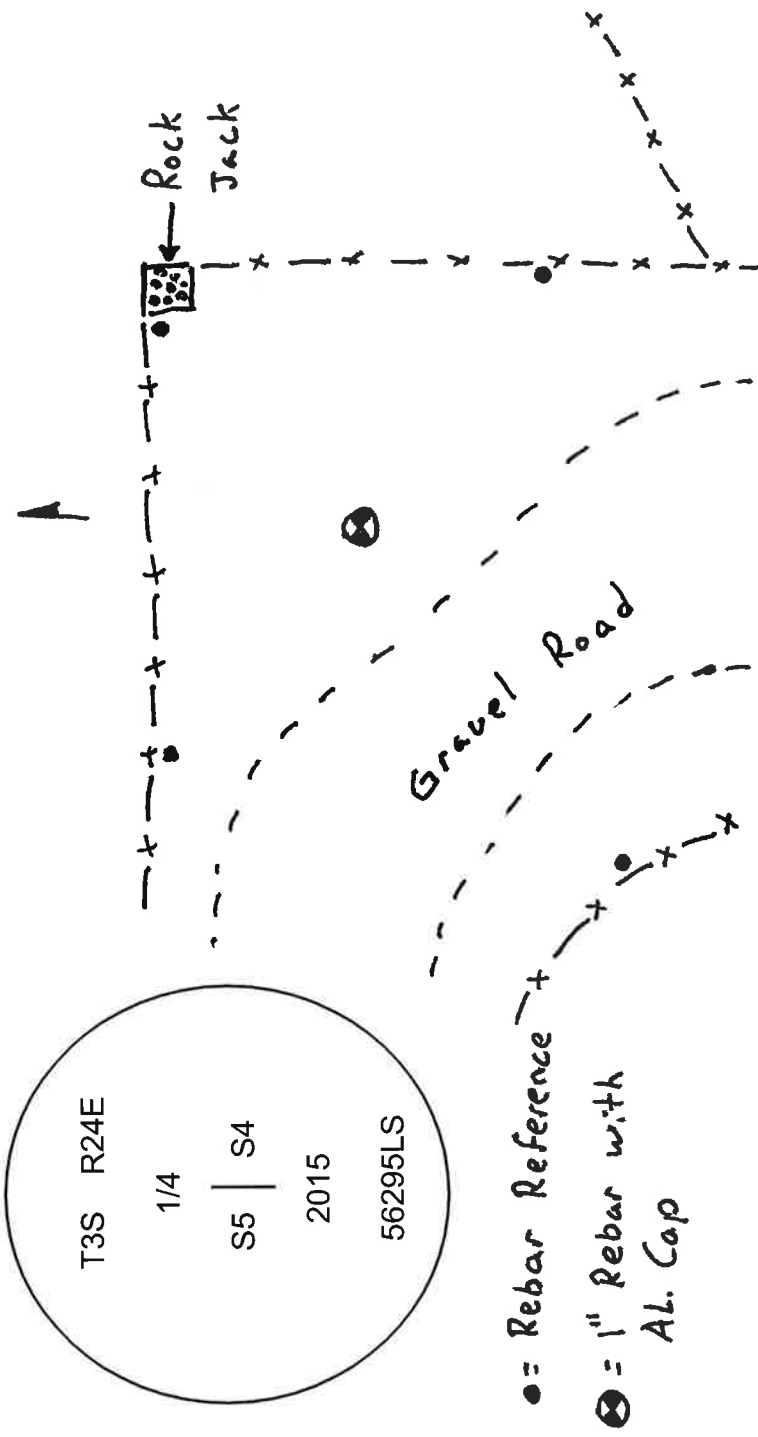

MONUMENT (S) AND ACCESSORIES SET (Procedures and Description)

I set a 1" x 24" iron rebar with a 2" aluminum cap stamped as shown in the diagram above at the intersection of road centerlines running south and west.

For references, I set three 5/8" by 24" iron rebars with 1 1/8" orange plastic caps stamped WTS and 56295LS as described below:
an iron rebar bears N46°31'12"E, 27.83 feet at the northwest corner of a rock crib;
an iron rebar bears S43°05'13"E, 37.53 feet under the road right of way fence;
an iron rebar bears S35°59'46"W, 90.63 feet under the road right of way fence;
an iron rebar bears N55°00'24"W, 37.14 feet under the road right of way fence;

The monument and references were tied using a Trimble R7/R8 RTK GPS.

Location and comments

Compass Declination

Surveyors Seal

RECEIVED BY:
Morrow County Surveyor
Date: 8-10-2015
Rec'd By: S.K.H.
No. 3524C9
Survey No. 2015-1746C

Firm / Agency
Witness Tree Surveying
Address
P.O. Box G
Pilot Rock, Or. 97868
Party Chief
Stephen K, Haddock

REGISTERED
PROFESSIONAL
LAND SURVEYOR

Stephen K. Haddock

OREGON
JULY 9, 2001
STEPHEN K. HADDOCK
56295LS

RENEWALS: 6 - 30 - 17