

**OREGON CORNER RESTORATION FORM**

Section 4 Township 3S Range 25E  
 County Morrow Date: August 21, 2002

Corner Designation: 3S25A11

Common quarter corner to section 33, T2S, R25E and section 4, T3S, R25E, W.M., Morrow County, Oregon.

Condition Report Only  
 Not found \_\_\_\_\_  
 Remonumented x  
 Unrecorded \_\_\_\_\_  
 Surveyed in \_\_\_\_\_  
 Referenced out x


Previous Renewals / Surveys, etc.

Corner originally set by David P. Thompson under contract #119 dated February 15, 1867. His record reads: Set a stone 15 x 8 x 7 for quarter section corner.


Monument and Accessories found: ( condition and source )

The original stone lying loose on the ground beside a rock crib fence corner with fences running north, south and east. The landowner, Mr. Bob Mahoney, stated that this corner has been in this position for at least 40 years that he knows of and I therefore hold it as the best available evidence.

**DIAGRAM**

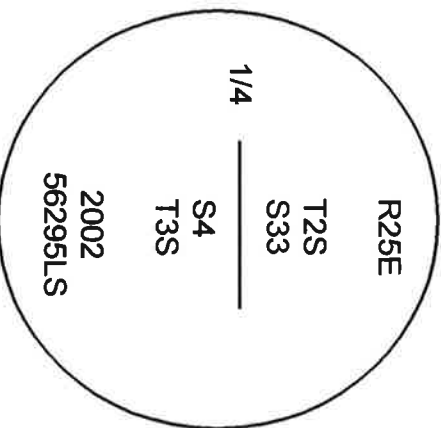

**SKETCH**

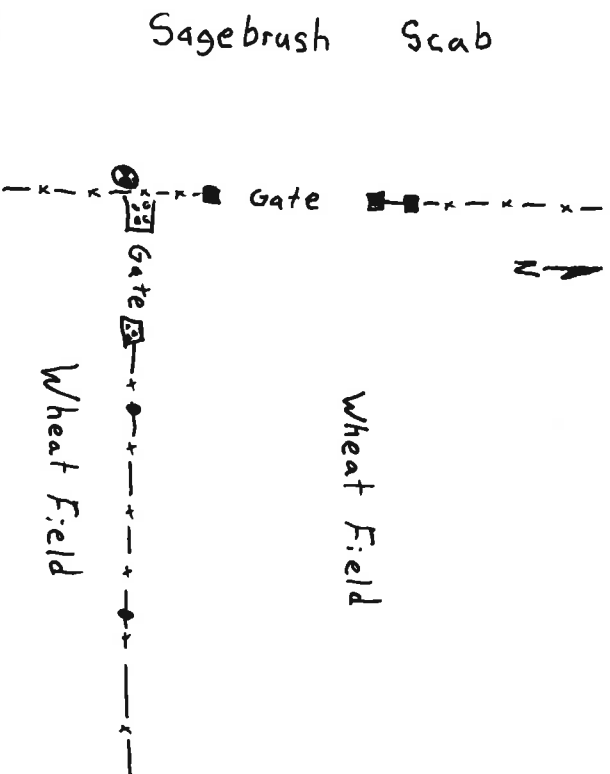

- ⊗ = Brass Cap
- = 5/8" Rebar Reference
- ▣ = Rock Jack
- = Railroad Tie post

**MONUMENT (S) AND ACCESSORIES SET (Procedures and Description)**

I set a 2 1/4" brass cap on a 30" galvanized iron pipe stamped as shown in the diagram above at the intersection of the fences. I buried the original stone along side of the brass cap.

For references, I set four 5/8" by 24" rebars with 1 1/8" orange plastic caps stamped WTS and 56295LS as described below:

- an iron rebar bears N00°02'59"W, 79.91 feet under the existing fence;
- an iron rebar bears S00°03'26"W, 33.47 feet under the existing fence;
- an iron rebar bears N88°42'18"E, 29.94 feet under the existing fence;
- an iron rebar bears N89°09'11"E, 56.69 feet under the existing fence;

The monument and references were tied using a LIECA system 300 RTK GPS.

Location and comments  
 Navigated position.  
 45°20'33.65" N  
 119°42'31.02" W

Compass Declination

Surveyors Seal

RECEIVED BY:

Morrow County Surveyor

Date: 1-4-14

Rec'd By: S.K.H.

No. Part 1: on 2003-02

Firm / Agency  
 Witness Tree Surveying  
 Address

P.O. Box G

Pilot Rock, Or. 97868

Party Chief

Stephen K, Haddock



*Stephen K. Haddock*



RENEWAL DATE 6-30-03