

**OREGON CORNER RESTORATION FORM**

Section 10 Township 3S Range 25E  
 County Morrow Date: January 14, 1999



Corner Designation: 3S25J17

Section corner common to sec's 10, 11, 14, & 15  
 T3S, R25E, W.M.

Condition Report Only  
 Not found   
 Remonumented   
 Unrecorded   
 Surveyed in   
 Referenced out

Previous Renewals / Surveys, etc.  
 The corner was originally established by D. Thompson under contract No. 122 approved november 5, 1867. His record reads "Set stone 17x10x5 for Corner to sec's 10, 11, 14, & 15.

Monument and Accessories found: ( condition and source )  
 Found the record dimension stone in place in a mound of stones. A fence corner rock jack was 3' east of this mound. The remains of fences could be seen running north south and west from this corner. The stone was unmarked.

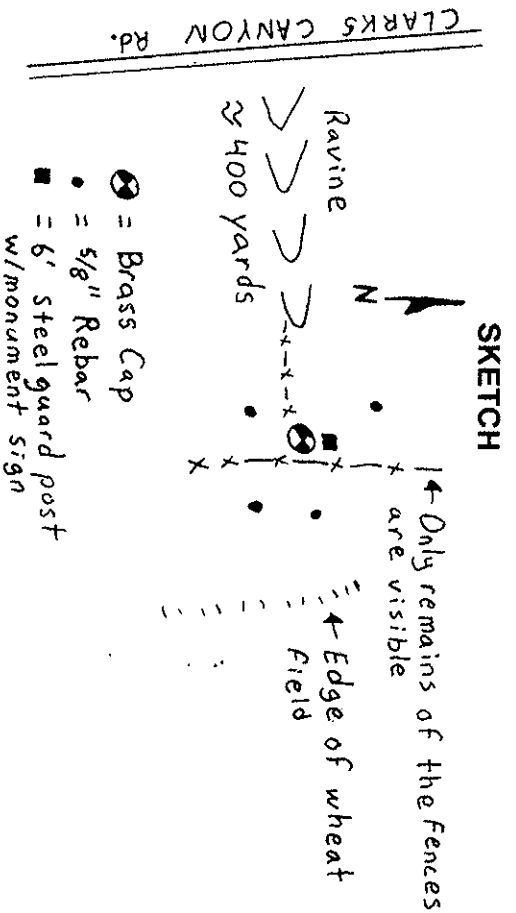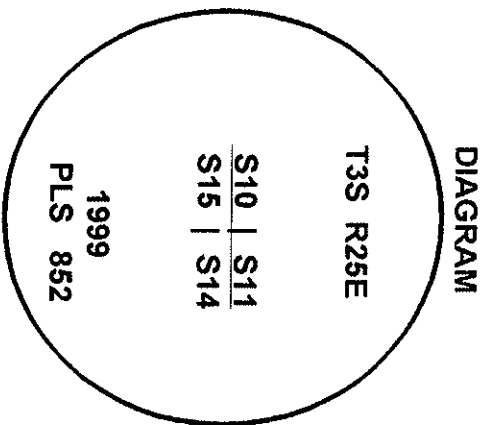

**MONUMENT (S) AND ACCESSORIES SET (Procedures and Description)**  
 Set a 2 1/4 inch brass cap on a 1 1/8" x 30" galvanized iron pipe stamped as shown in the diagram above 28" in the ground. Placed a 2' collar of stone around the cap. Buried the stone along side the cap.

**REFERENCES SET:**

- A 5/8" x 24" rebar with a 1 1/8 inch red plastic cap stamped ORLS 852 and WALs 13922 bears N34°56'30"W a distance of 42.09 feet.
- A 5/8" x 24" rebar with a 1 1/8 inch red plastic cap stamped ORLS 852 and WALs 13922 bears N87°43'22"E a distance of 18.50 feet.
- A 5/8" x 24" rebar with a 1 1/8 inch red plastic cap stamped ORLS 852 and WALs 13922 bears S44°43'18"E a distance of 20.98 feet.
- A 5/8" x 24" rebar with a 1 1/8 inch red plastic cap stamped ORLS 852 and WALs 13922 bears S33°31'25"W a distance of 20.98 feet.

Location and comments  
 Monument and references  
 located using GPS.

Compass Declination

Surveyors Seal

RECEIVED BY:  
 Morrow County Surveyor  
 Date:  
 Rec'd By:  
 No.

Firm / Agency  
 Haddock Surveying  
 Address  
 P.O. Box 1574  
 Pendleton, Or. 97801  
 Party Chief  
 Stephen K, Haddock



*David L. Haddock*  
 OREGON  
 JULY 12, 1988  
 DAVID L. HADDOCK  
 852