


# RECORD OF LAND CORNER MONUMENTATION

CORNER: SE Cor. Sec. 8, Twp. 3S., R.26E., W.M.

ORIGINAL SURVEY BY: George Williams, U.S. Deputy Surveyor

CONTRACT NUMBER: 176

CONTRACT DATE: July 20, 1872

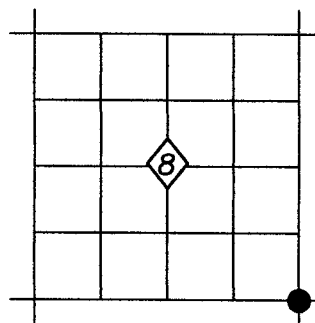

**ORIGINAL G.L.O. DESCRIPTION:** Set Stone 22x11x6 for corner to Sections 8, 9, 16, 17 on level plateau.

**EVIDENCE FOUND:** After a diligent search, I was unable to find original GLO evidence at this corner location. I did locate the shoulders and right of way fences for County Road No. 614 to the North and South of the search area for this corner.

I also searched the County Road Department file for County Road 614. The documentation for this road, including the original petition dated March 8, 1888, indicate that this section corner should be located on the centerline of Stock Drive Road (County Road 614). I found very little consistency in the width and alignment when using the shoulders of the existing road to determine a centerline intersection. I found that the right of way fences were a better indication of the actual location of the county road centerline. I held the midpoint between right of way fences and intersected with a fence line running East from the county road. There are also remains of a fence to the west at this point. The centerline of the county road is coincident with the east line of said Section 8.

**DESCRIPTION OF MONUMENT AND ACCESSORIES SET:**

At a point on the centerline of County Road 614 as determined above, I set a 5/8" X 10" iron pin, driven to refusal, with attached 2 1/2" aluminum cap, 11" in the ground. Cap is marked as shown below.

**FROM WHICH, I set the following reference points:**


A 5/8"x30" iron pin bears N.45°47'E., 41.29 ft., with attached yellow plastic cap marked BENCHMARK SURVEYING (set near North-South fence line)

A 5/8"x30" iron pin bears S.42°15'E., 41.32 ft., with attached yellow plastic cap marked BENCHMARK SURVEYING

A 5/8"x30" iron pin bears S.48°22'W., 36.99 ft., with attached yellow plastic cap marked BENCHMARK SURVEYING

A 5/8"x30" iron pin bears N.50°34'W., 34.83 ft., with attached yellow plastic cap marked BENCHMARK SURVEYING (set near North-South fence line)

Used RTK GPS to measure RP's. Bearings to RP's are based on Geodetic North from a GPS observation taken near the Northeast Corner of Section 8, T3S., R.26E., W.M.

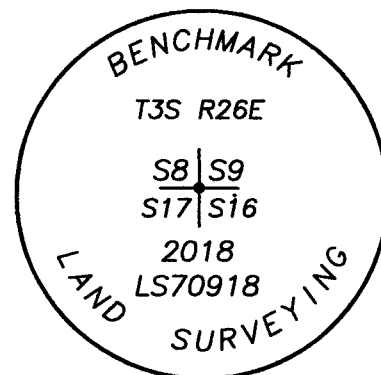

**RESTORATION BY:**

Michael C. Springer, PLS  
217 N. Canyon Blvd.  
John Day, OR, 97845  
(541) 575-1251

Surveyed October 1, 2018



EXPIRES: 6/30/2020

**RECEIVED BY**

Morrow County Surveyor

Date: 10-22-2018

Rec'd By: S.K.H.

No.: 3526J9

Folder No.: \_\_\_\_\_