


**CERTIFIED RECORD OF LAND CORNER MONUMENTATION**

U.S.F.S. INDEX No. A-1

**History of original corner establishment:** This corner was originally established by George Williams in 1872, under GLO Contract No. 172.

**DIAGRAM**

Surveyor General Field Notes State:  
Set stone 24x10x8 the corner to Townships 3 and 4 S.,  
Ranges 26 and 27 East.

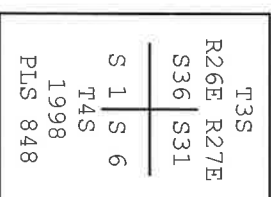

**Description of Corner Evidence Found:**

Found a large mound of stones with the remains of an old N & W running fence line. Newer fence corner bears S45°E, 25 feet from the mound of stones.

**Description of monument and accessories I established to perpetuate the original location of this corner:**


At the position of the mound of stones, Set a 2-1/2"x30" aluminum pipe with 2-1/2" aluminum cap, stamped as shown in DIAGRAM, 12" in the ground. Raised a 3 ft. dia. by 1.5 ft. high mound of stone around monument. From which:

Set a 5/8"x30" iron pins with plastic caps stamped PLS 848 at the following bearings and distances:

- N42°W, 14.5 ft. in 1 ft.x1 ft. md. of stone
- N50°E, 13.0 ft., one groove in top of pin.
- S48°E, 13.4 ft., in 2 ft.x1.5ft. md. of stone, two grooves in top of pin.
- S69°W, 16.4 ft., in 1 ft.x1 ft. md. of stone three grooves in top of pin.

Measurements to accessories taken with a magnetic compass, declination 17°east, and a nylon clad steel tape.

This work was performed by:  
Douglas M. Ferguson, PLS 848  
Witnessed by: D. Mitchell Ferguson  
and Brad Cates  
Date: 4-17-98

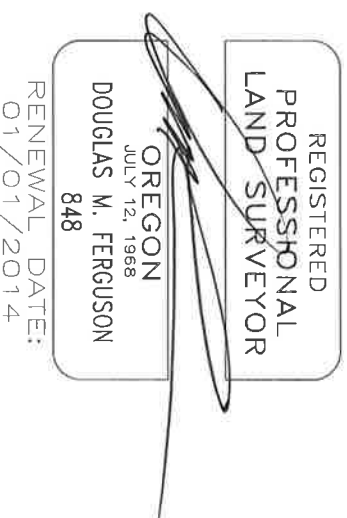

Office of Surveyor, County of Morrow, State of Oregon,  
I hereby certify that the within instrument was  
filed in this office for record on the 23 day of August, 2013

Steve K. Alford by \_\_\_\_\_  
(COUNTY OFFICIAL) (DEPUTY)

Refer to Morrow County Map No. 2013-34D