


CERTIFIED RECORD OF LAND CORNER MONUMENTATION

U.S.F.S. INDEX No. A-5

History of original corner establishment: This corner was originally established by George Williams in 1872, under GLO Contract No. 172.

DIAGRAM

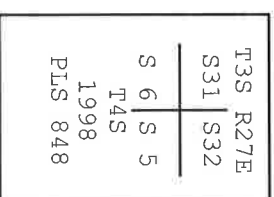

Surveyor General Field Notes State:

Set stone 24x8x6 the corner to Sections 31, 32, 5 and 6

Description of Corner Evidence Found:

Found a tacked hub in a mound of stones. No stones of record size. Accepted as corner position.

Description of monument and accessories I established to perpetuate the original location of this corner:


At the position hub in the mound of stones, Set a 2-1/2"x30" aluminum pipe with 2-1/2" aluminum cap, stamped as shown in DIAGRAM, 22" in the ground. Raised a 2 ft. dia. by 8 in. high mound of stone around monument. From which:

Set a 5/8"x30" iron pins with plastic caps stamped PLS 848 at the following bearings and distances:

- N50°W, 10.3 ft.
- N32°30'E, 10.5 ft., one groove in top of pin.
- S47°30'E, 10.8 ft., two grooves in top of pin.
- S33°W, 10.6 ft., three grooves in top of pin.

Measurements to accessories taken with a magnetic compass, declination 17°east, and a nylon clad steel tape.

This work was performed by:
Douglas M. Ferguson, PLS 848
Witnessed by: D. Mitchell Ferguson
and Brad Cates
Date: 4-17-98

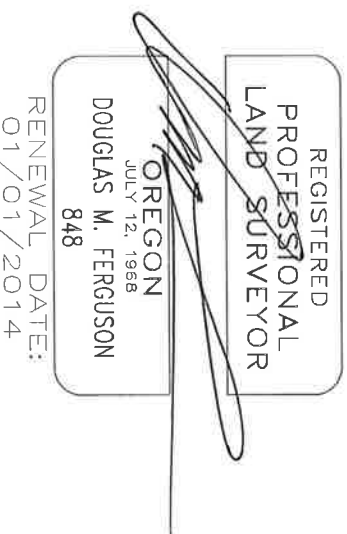

Office of Surveyor, County of Morrow, State of Oregon,
I hereby certify that the within instrument was
filed in this office for record on the 23 day of August, 2013

Steph V. Madlock by _____
(COUNTY OFFICIAL) (DEPUTY)

Refer to Morrow County Map No. 2013-34D