


CERTIFIED RECORD OF LAND CORNER MONUMENTATION

U.S.F.S. INDEX No. E-1

History of original corner establishment: This corner was originally established by Zenas F. Moody in 1873, under GLO Contract No. 184.

DIAGRAM

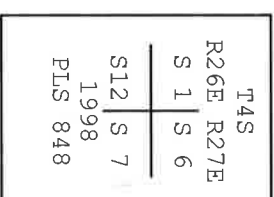

Surveyor General Field Notes State:

Set stone 14x12x8 in earth mound for Cor. to Secs 1, 12, 6 & 7

Description of Corner Evidence Found:

No original corner evidence found. Set a proportionate measure from the corners 1 mile north and 1 mile south.

Description of monument and accessories I established to perpetuate the original location of this corner:

At the proportionate position, Set a 2-1/2"x30" aluminum pipe with 2-1/2" aluminum cap, stamped as shown in DIAGRAM, 25" in the ground.

From which:

Set a 5/8"x30" iron pins with plastic caps stamped PLS 848 at the following bearings and distances:

- N41°W, 10.7 ft.
- N43°E, 10.1 ft., one groove in top of pin.
- S41°E, 10.5 ft., two grooves in top of pin.
- S40°W, 10.2 ft., three grooves in top of pin.


Measurements to accessories taken with a magnetic compass, declination 17° east, and a nylon clad steel tape.

This work was performed by:

Douglas M. Ferguson, PLS 848

Witnessed by: D. Mitchell Ferguson and Brad Cates

Date: 4-17-98

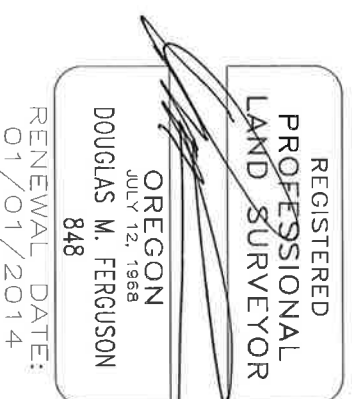

Office of Surveyor, County of Morrow, State of Oregon,
 I hereby certify that the within instrument was
 filed in this office for record on the 23 day of August, 2013

Dora V. Hubbard by _____
 (COUNTY OFFICIAL) (DEPUTY)

Refer to Morrow County Map No. 2013-34D